


# T. IS. R.I.E.W.M.

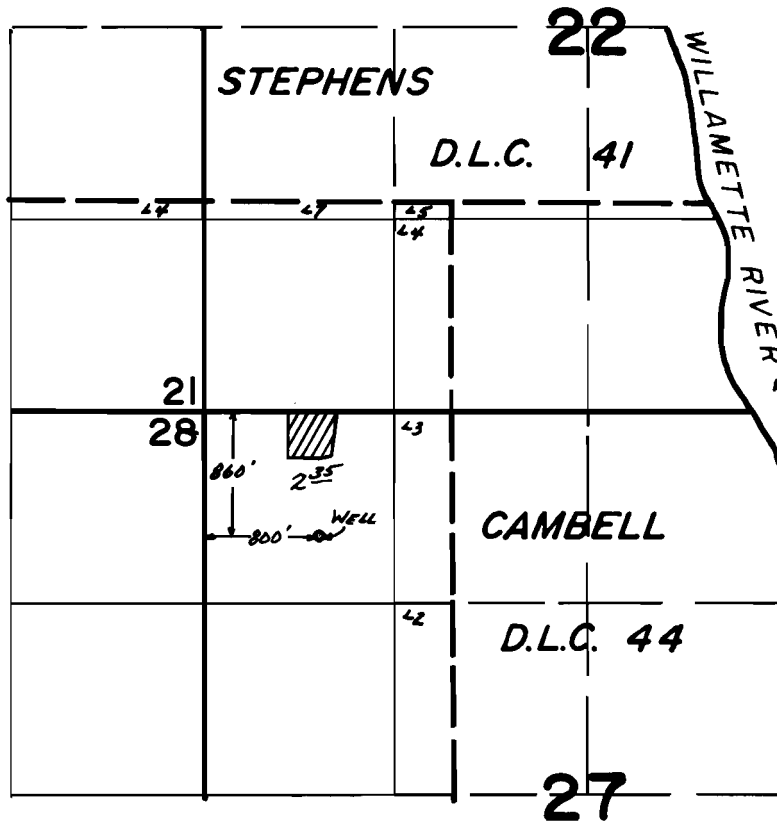

## FINAL PROOF SURVEY UNDER

Application No. G-8177. Permit No. G-7569.  
IN NAME OF

RIVERVIEW CEMETERY ASSOC.

Surveyed Oct. 26, 1978, by R.G. Mucken...