


T. 1S. R. 4E. W.M.

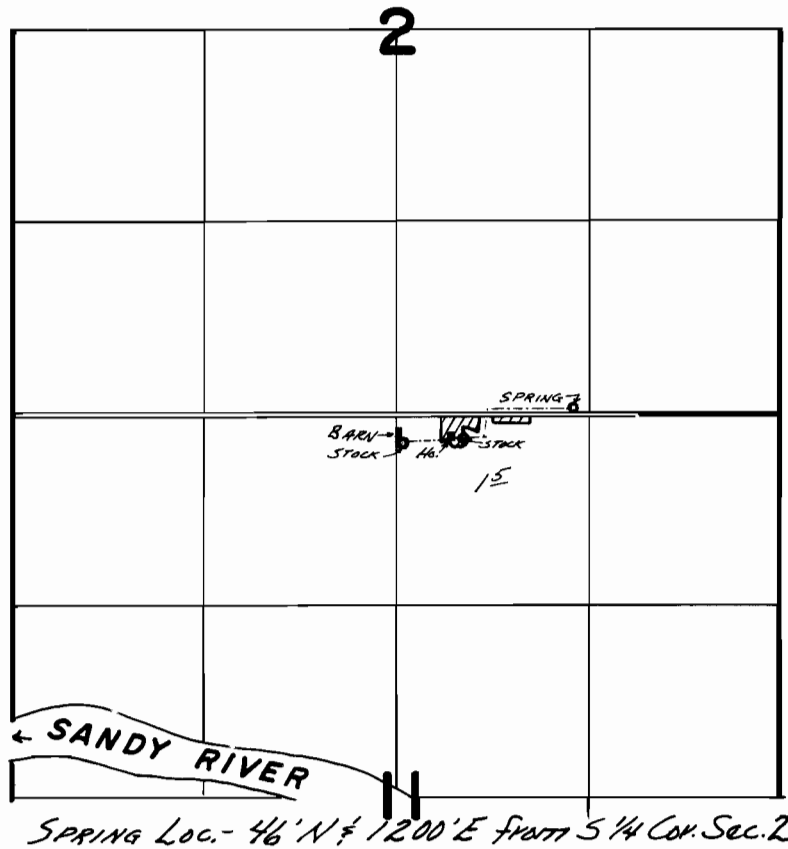

FINAL PROOF SURVEY
UNDER

Application No. 52465 Permit No. 37747
IN NAME OF

IRENE C. FARMER

Surveyed Oct. 26 1978, by R.G. Mucken