


# T. 7S., R. 3W., W.M.

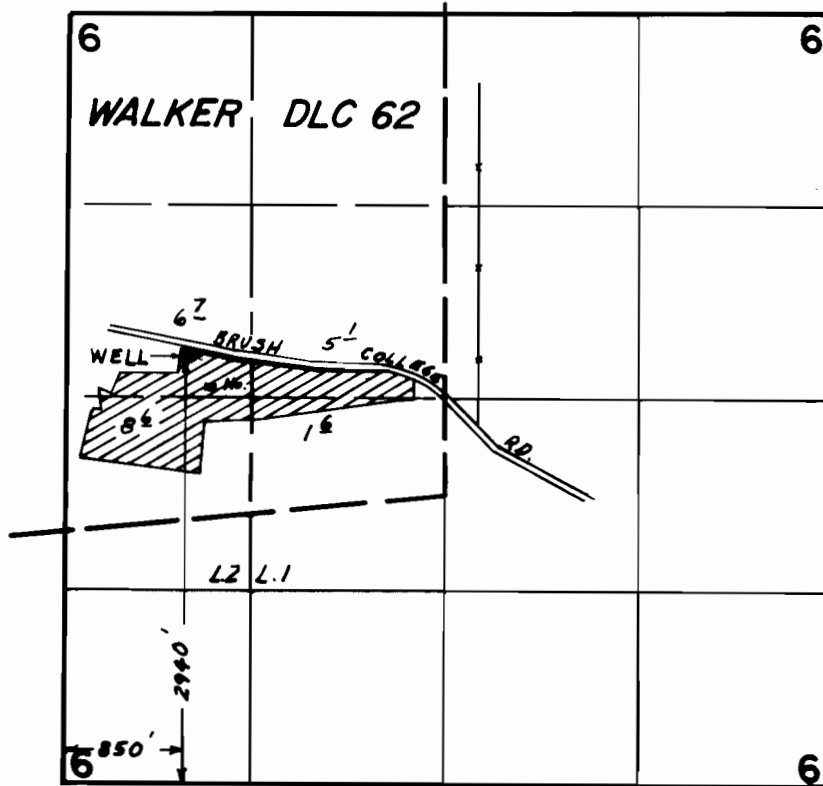

## FINAL PROOF SURVEY UNDER

Application No. G-6129. Permit No. G-5799.  
IN NAME OF

HAROLD W. KNITTEL

Surveyed MAR. 10. 1978. by J.S. DONALDSON