


T.8S. R.6W., W.M.

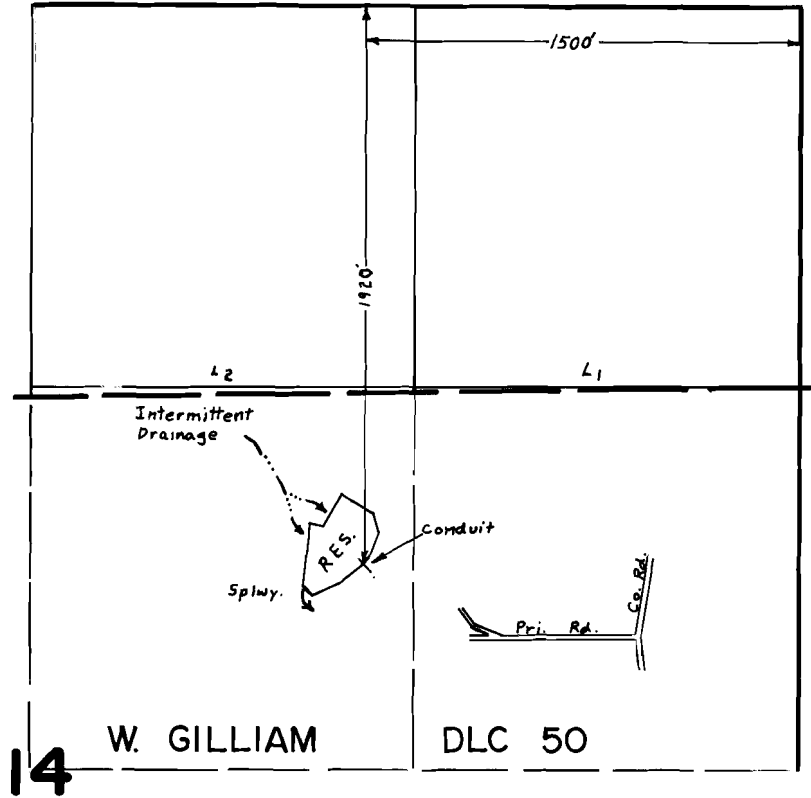

Scale : 1" = 660'

FINAL PROOF SURVEY UNDER

R-50299 R-6144
Application No. 50300 Permit No. 37987.....
IN NAME OF

PHILLIP MURRAY

Surveyed MAR. 14. 1978., by J. S. DONALDSON