


# T. 9 S., R. 4 W., W.M.

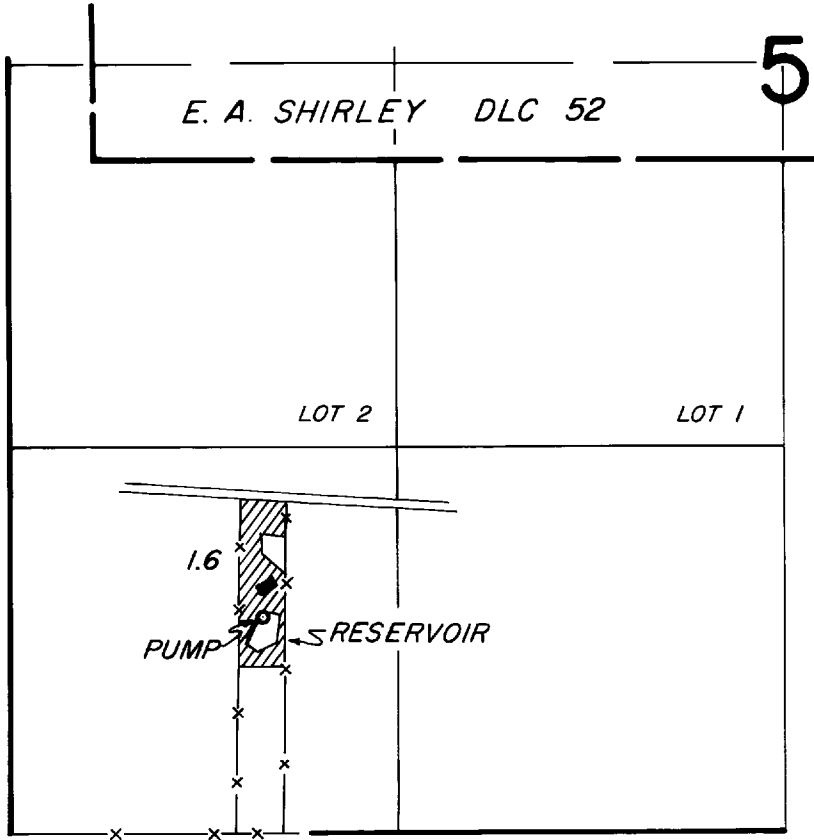

SCALE 1" = 660'

## FINAL PROOF SURVEY UNDER

R-52093 R-6078  
Application No. 52094 Permit No. 3741Q.....  
IN NAME OF

**NORMAN E. FAIRCHILD**

Surveyed MAR. 17, 1978, by S. DONALDSON