


T. 9 S., R. 4 W., W.M.

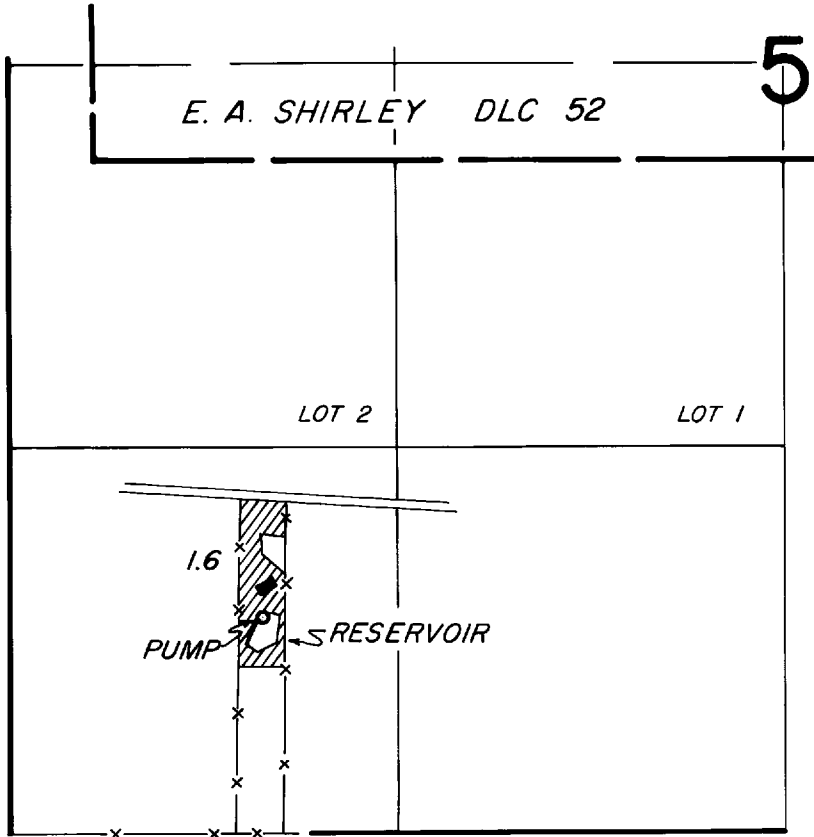

SCALE 1" = 660'

FINAL PROOF SURVEY UNDER

R-52093 R-6078
Application No. 52094 Permit No. 37410.....
IN NAME OF

NORMAN E. FAIRCHILD

Surveyed MAR. 17, 1978, by S. DONALDSON