


T5S. RIOW. WM.

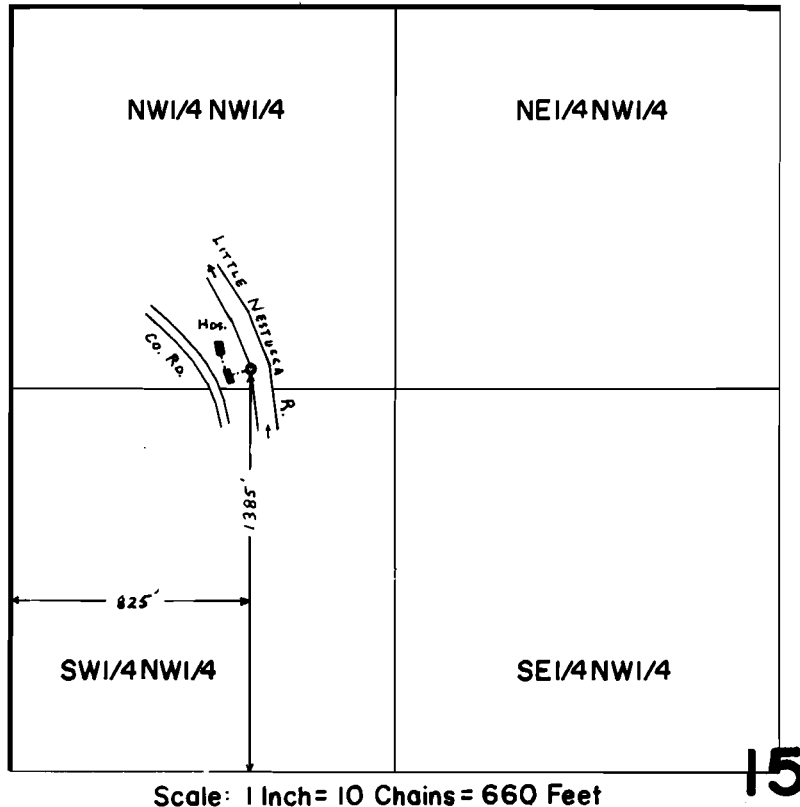

FINAL PROOF SURVEY
UNDER

Application No. 50380 Permit No. 37381
IN NAME OF

ERVIN L. ASHMORE

Surveyed SEPT. 21 1978, by C. L. HUGHES