


10

LAKE WALLULA
COLUMBIA RIVER

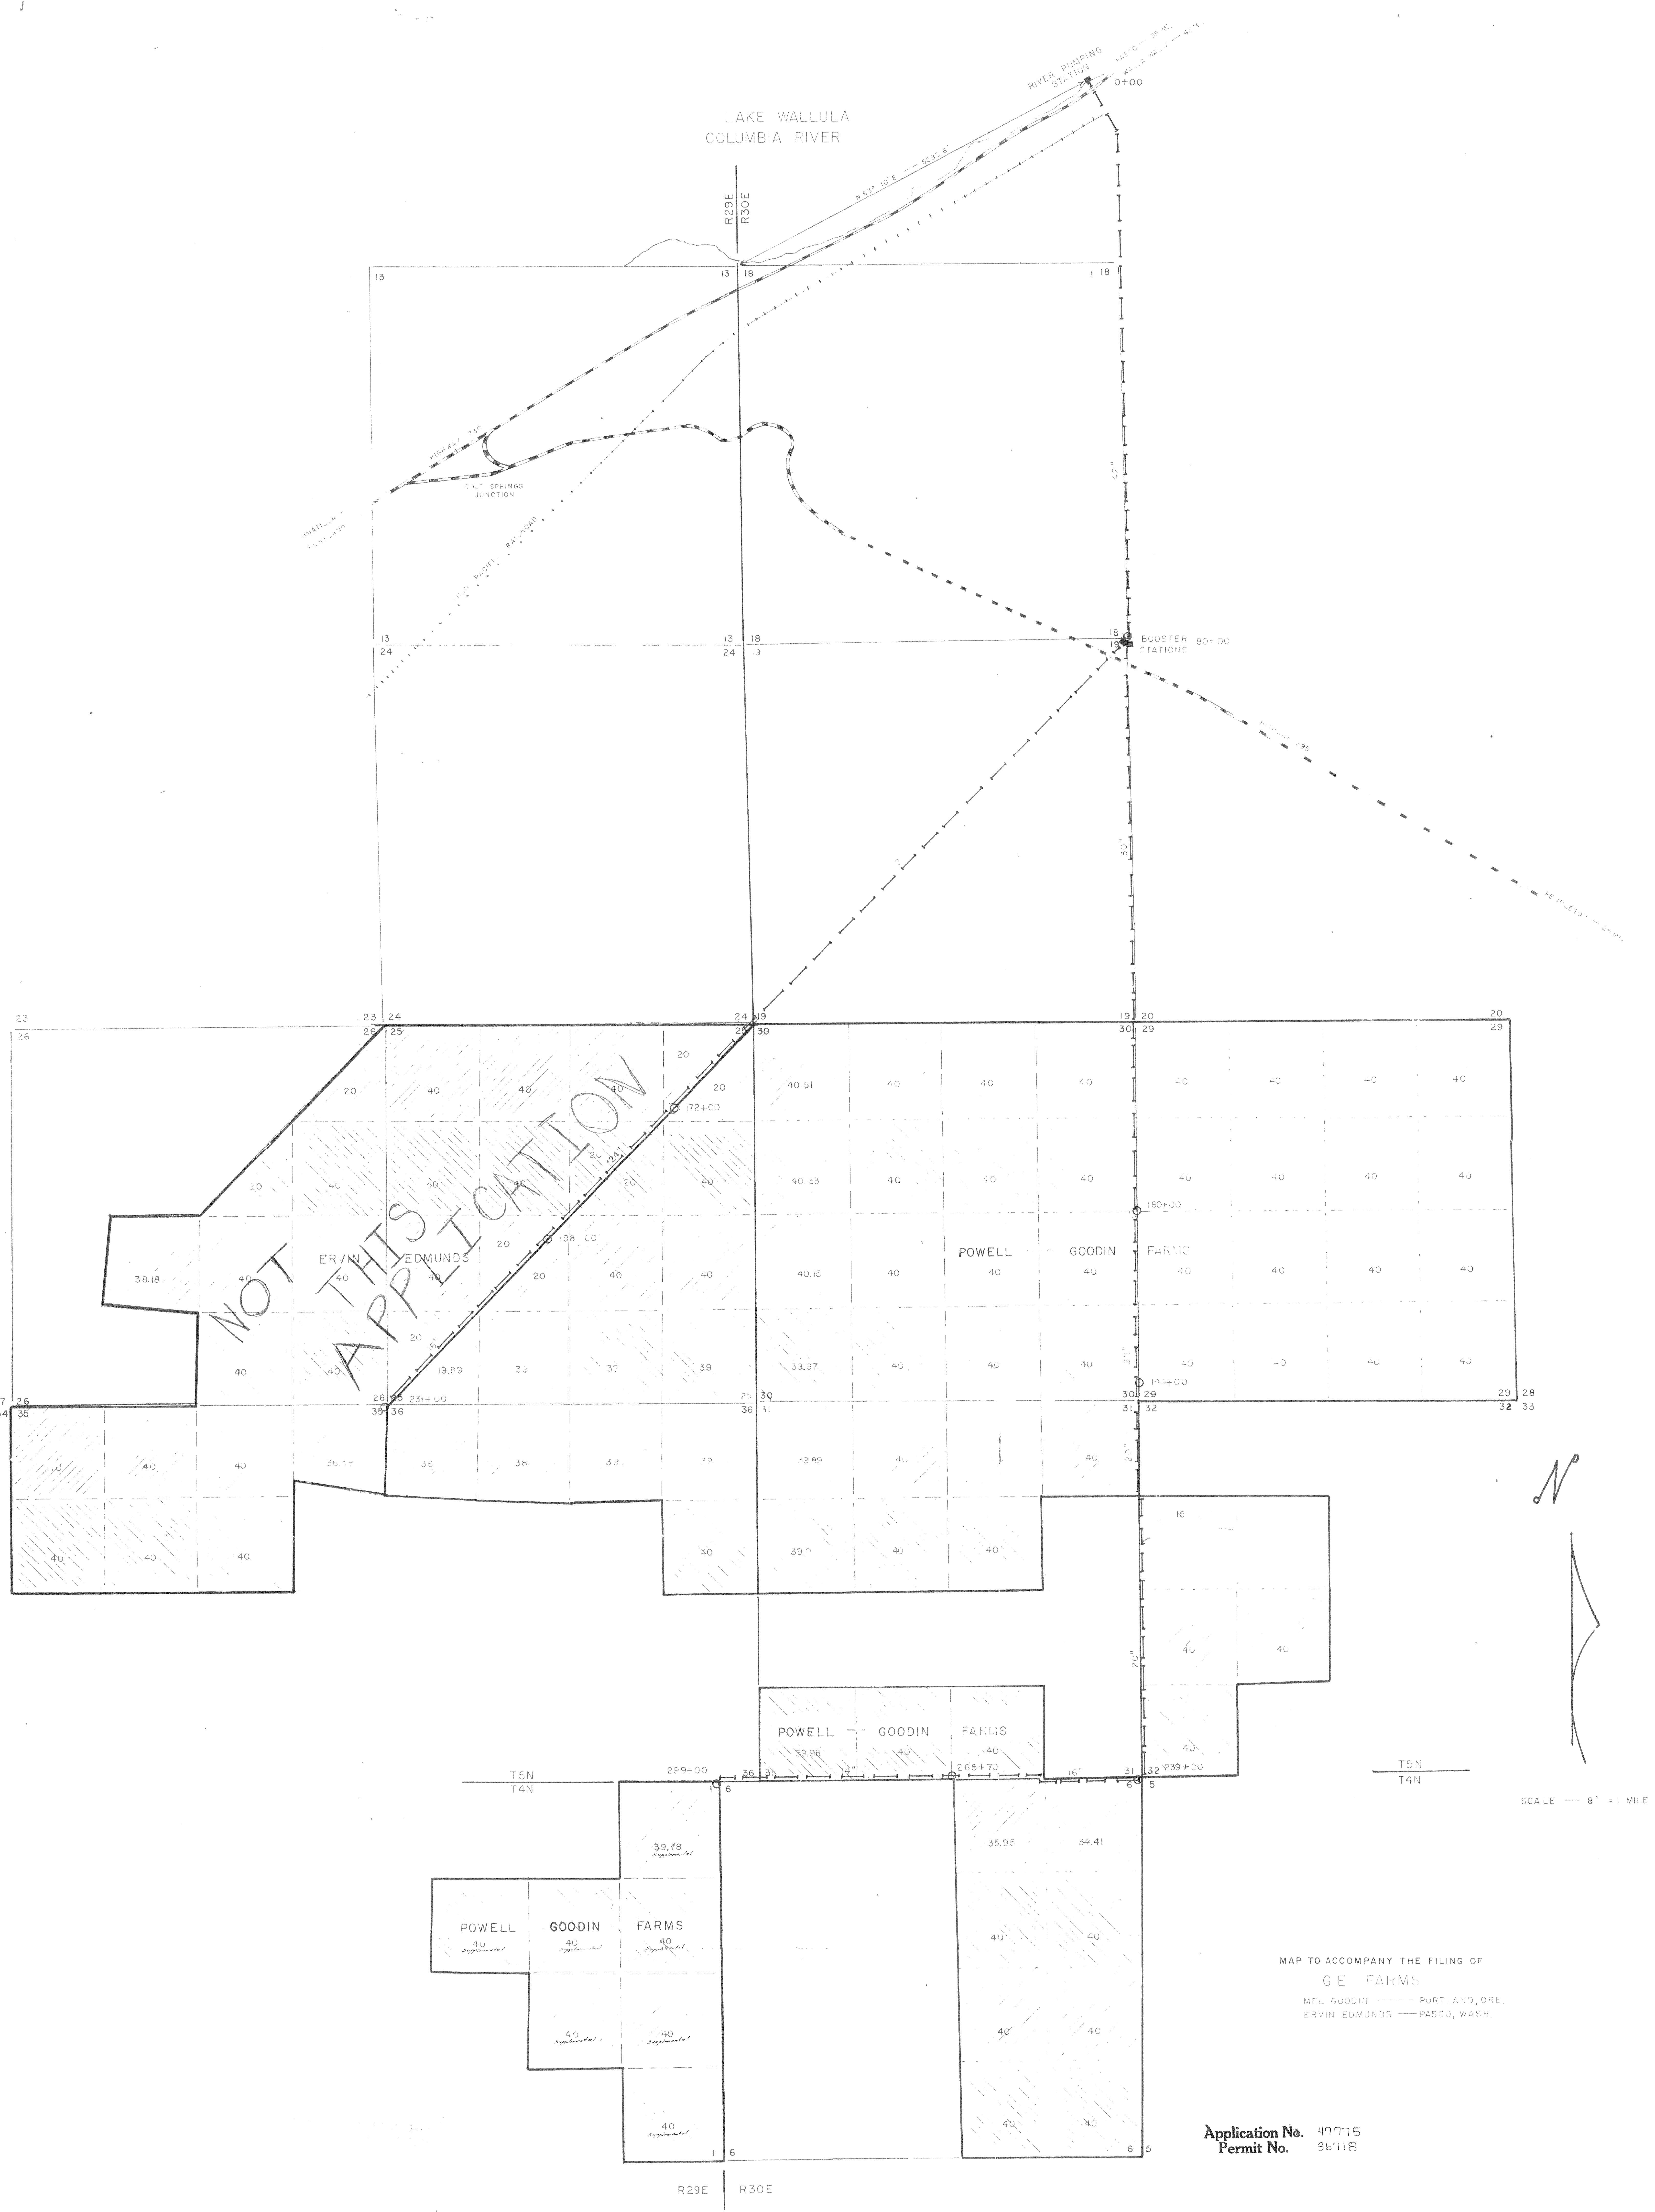


MAP TO ACCOMPANY THE FILING OF
 GE FARMS
 MEL GOODIN — PORTLAND, ORE.

Application No. 47775
 Permit No. 36718

SCALE — 8" = 1 MILE

R29E R30E

T5N T4N

T5N T4N