


T. IS. R. 3W. W.M.

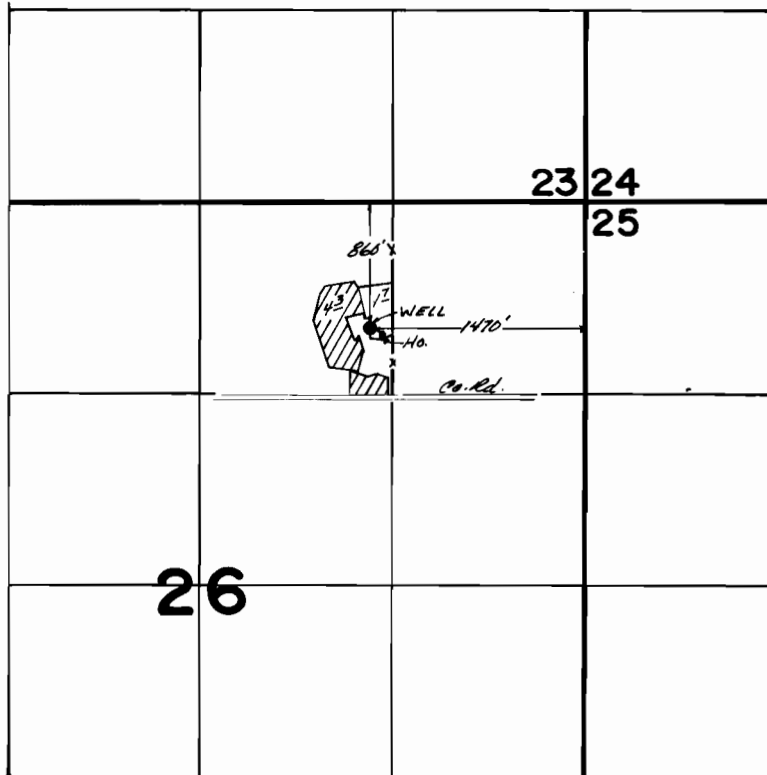

FINAL PROOF SURVEY UNDER

Application No. G-8353 Permit No. G-7795
IN NAME OF

CECIL FAY OSTRANDER

Surveyed July 27 1978, by R.G. Mucken