


T. IS. R. 2W. W. M.

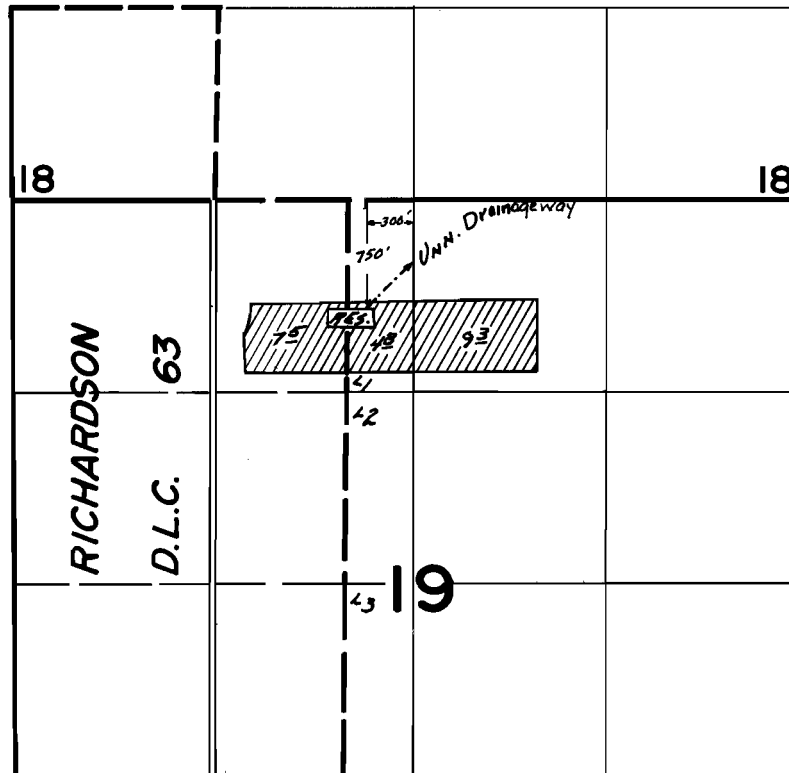

FINAL PROOF SURVEY UNDER

R-51826 R-6253
Application No. 51827..... Permit No. 39028..
IN NAME OF

FRED BARBY.....

Surveyed July 27, 1978, by R.G. Mucken....