


T.5S., R.6W., W.M.

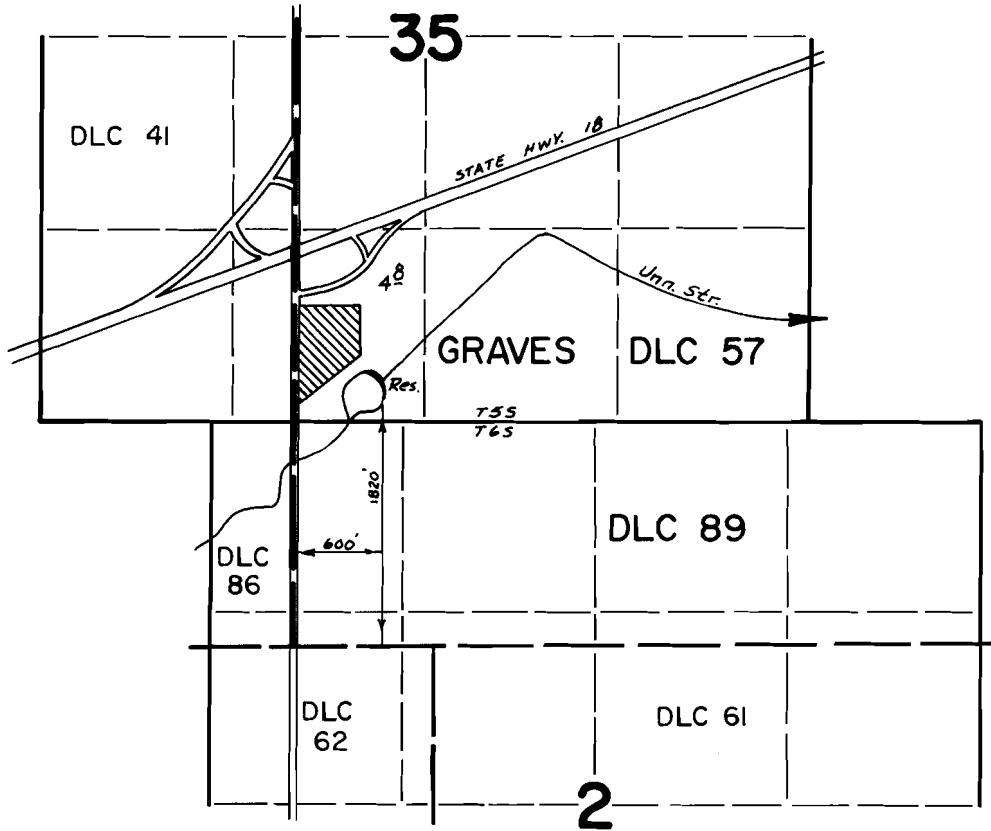

FINAL PROOF SURVEY UNDER

R-49764 R-5845
Application No. 49777 Permit No. 36093
IN NAME OF

GREEN CREST MEMORIAL PARK ASSOCIATION

Surveyed May 11 1976, by L.H. Nunn