


# T.5S., R.6W., W.M.

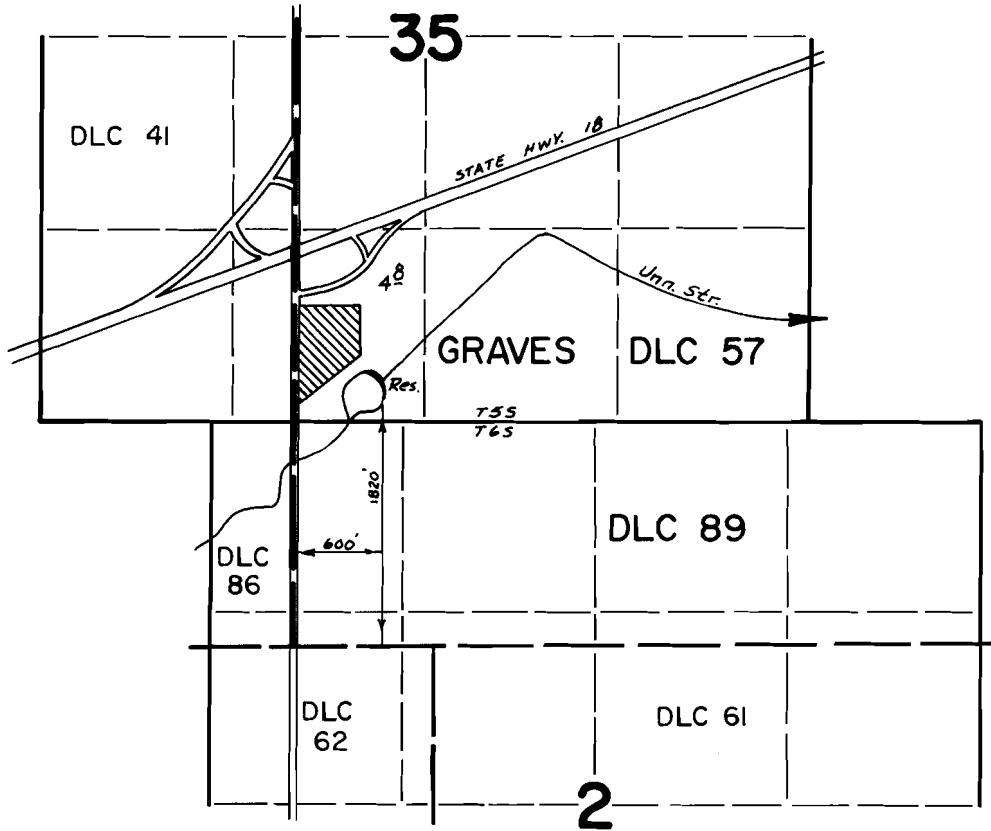

## FINAL PROOF SURVEY UNDER

R-49764                      R-5845  
Application No. 49777    Permit No. 36093  
IN NAME OF

GREEN CREST MEMORIAL PARK ASSOCIATION

Surveyed May 11 1976, by L.H. Nunn