


T. 8S. R. 39E. W.M.

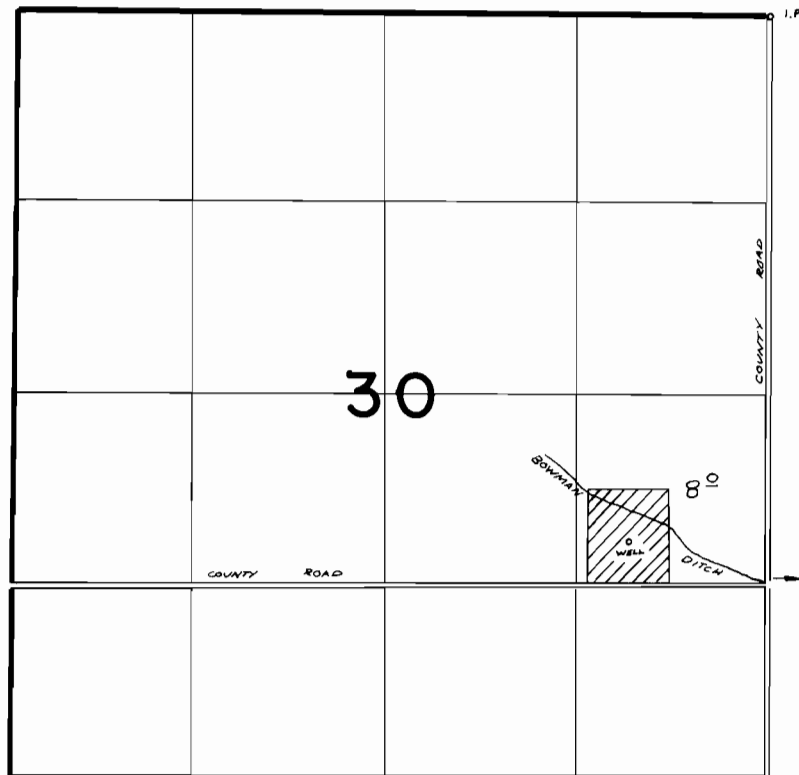

WELL LOC. 1000'S & 950'W FROM E 1/4 COR SEC 30

**FINAL PROOF SURVEY**  
UNDER

Application No. G-7690 Permit No. G-7116  
IN NAME OF

..... GORDYS B. DIERS .....

Surveyed ..6-1..... 1978.. by R. SARKIS.....