


# T13 & 14S. R7W. WM.

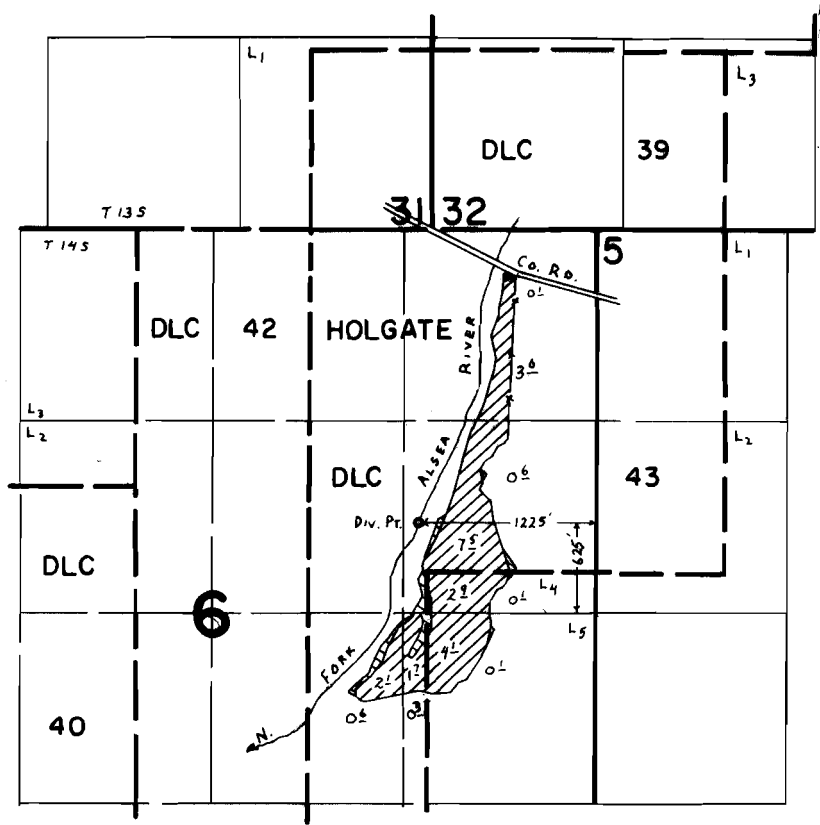

## FINAL PROOF SURVEY UNDER

Transfer No. T-3352  
 Application No. ~~53720~~ Permit No. ~~40343~~.....

IN NAME OF  
**ELIZABETH BOND STARKER**

Surveyed Aug. 16, 19.79, by C. L. HUGHES.....