


T2S. RIE. WM.

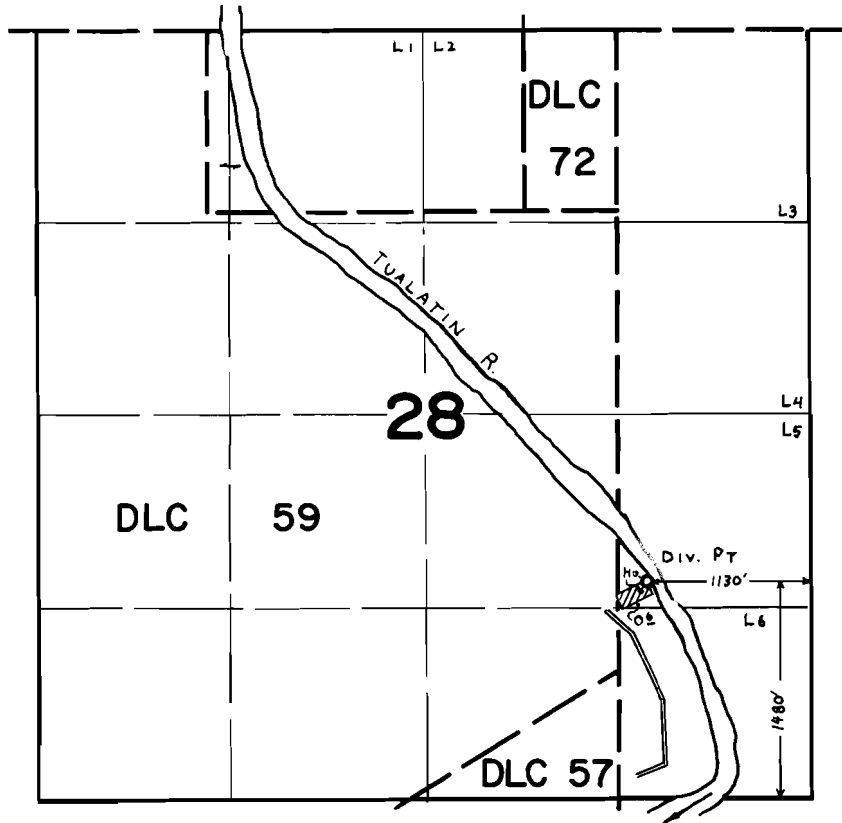

FINAL PROOF SURVEY UNDER

Application No. 54035 Permit No. 40416
IN NAME OF

STANLEY F. DAHL

Surveyed JUNE 8 1978, by C. L. HUGHES