


T5S. R2E. WM.

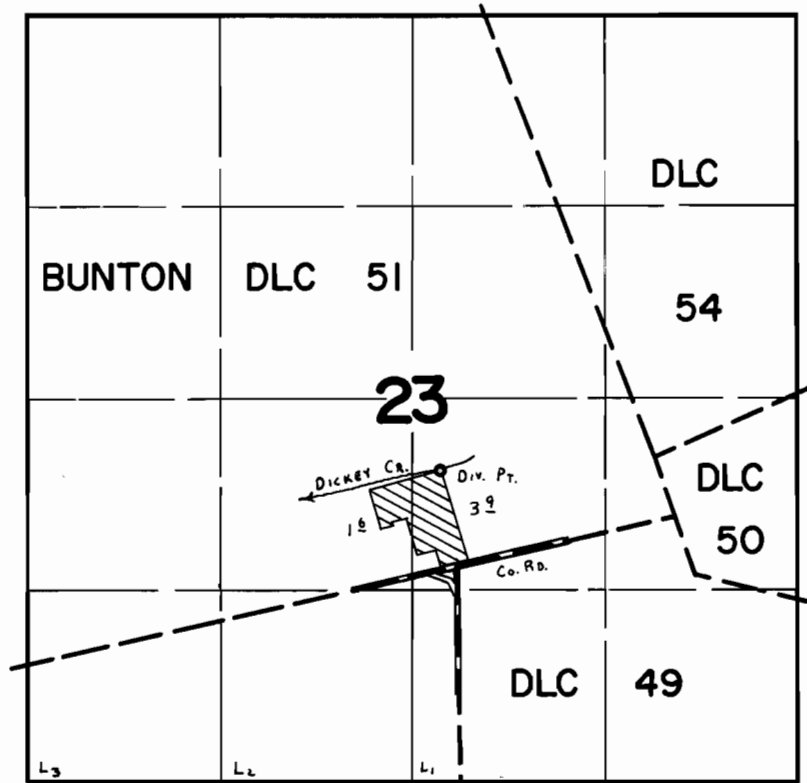

Div. Pt. Loc: 640' N. & 120' W. fr. N.W. Cor. Dickey DLC 49.

FINAL PROOF SURVEY UNDER

Application No. 54048 Permit No. 40274
IN NAME OF

MAYNARD T. BROWN

Surveyed OCT. 9 1978, by C. L. HUGHES