


T3S. R1E. WM.

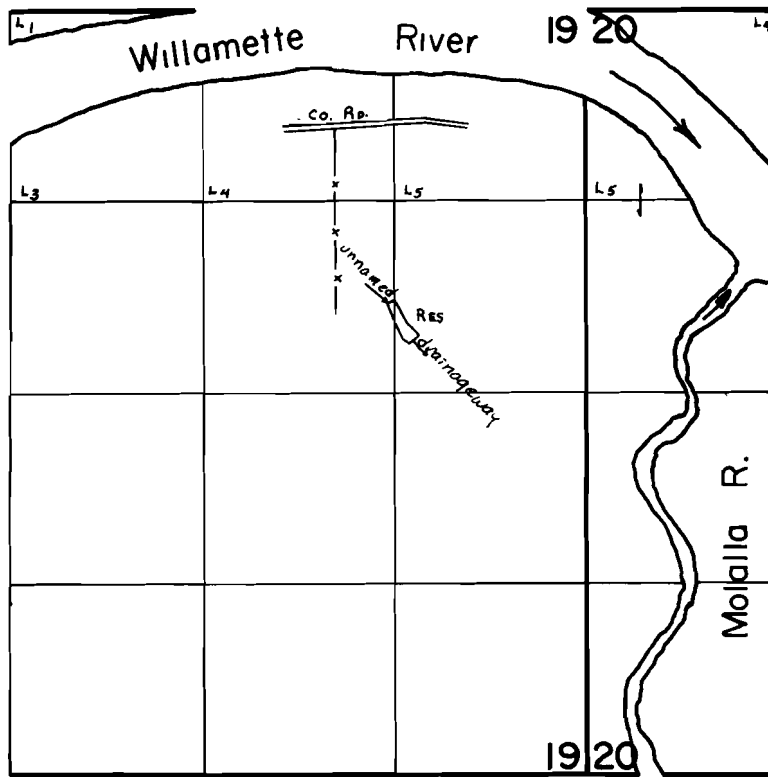

DAM Loc: 3,000' N. & 1180' W. fr. S.E. CoR. Sec. 19.

FINAL PROOF SURVEY UNDER

Application No. 54795 Permit No. 40831
R-54343 R-6509
IN NAME OF

LANCE D. EMORY

Surveyed JUNE 6, 1978, by C. L. HUGHES