


T3S. R1E. WM.

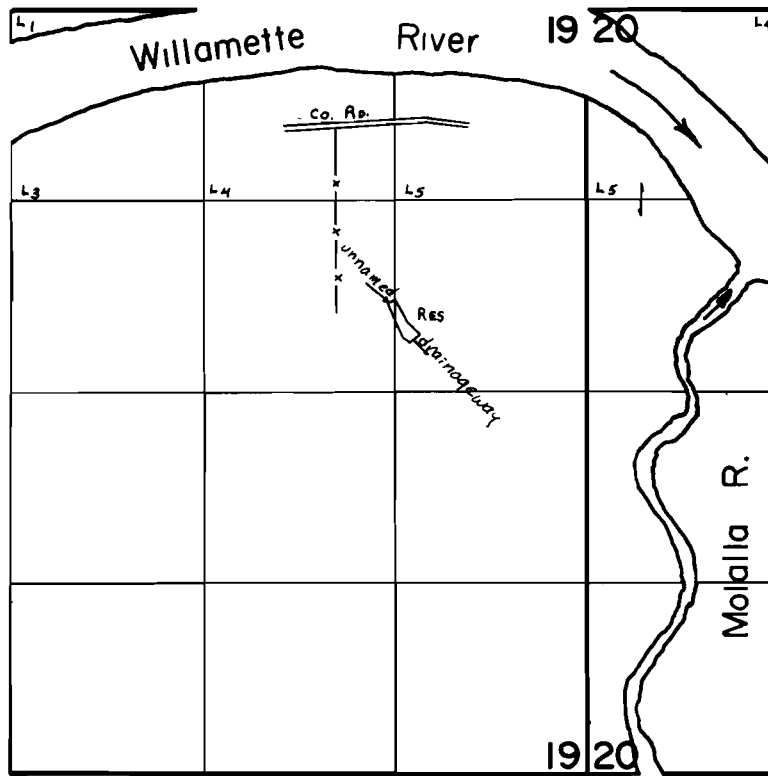

DAM Loc: 3,000' N. & 1180' W. fr. S.E. CoR. Sec. 19.

FINAL PROOF SURVEY UNDER

54795 40831
Application No. R-54343 Permit No. R-6509
IN NAME OF

..... LANCE D. EMORY

Surveyed JUNE 6, 1978, by C. L. HUGHES