


# T5S. RIW. & IE. WM.

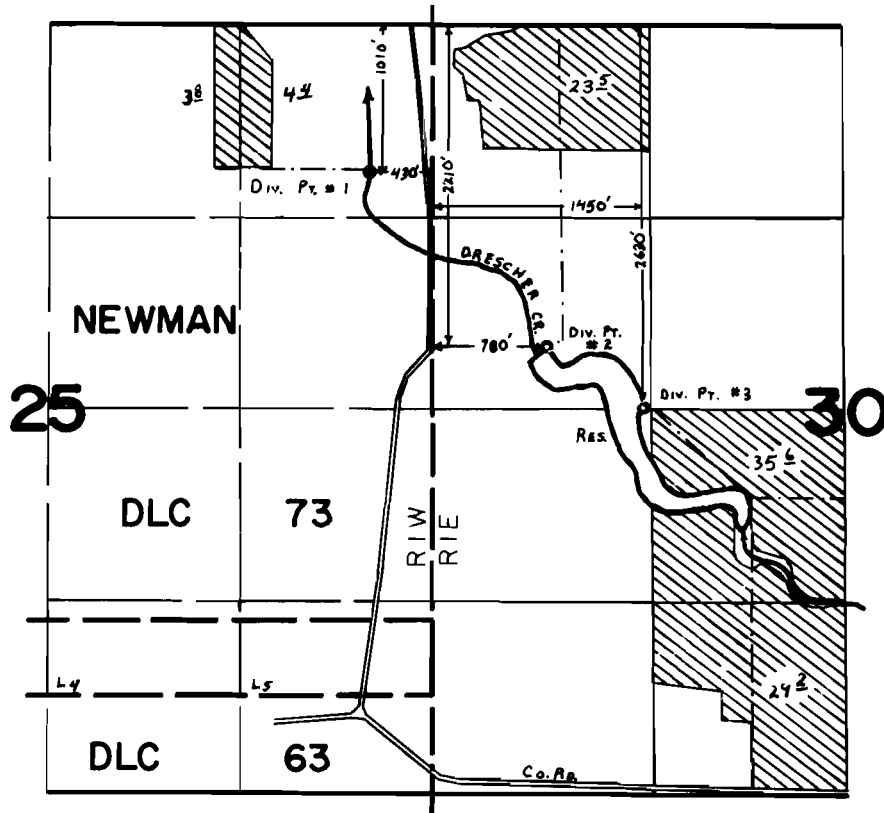

## FINAL PROOF SURVEY UNDER

Application No. 55442... Permit No. 41820...  
IN NAME OF

FRED DRESCHER

Surveyed SEPT. 25 1978, by C. L. HUGHES...