


# T3S. R4E. WM.

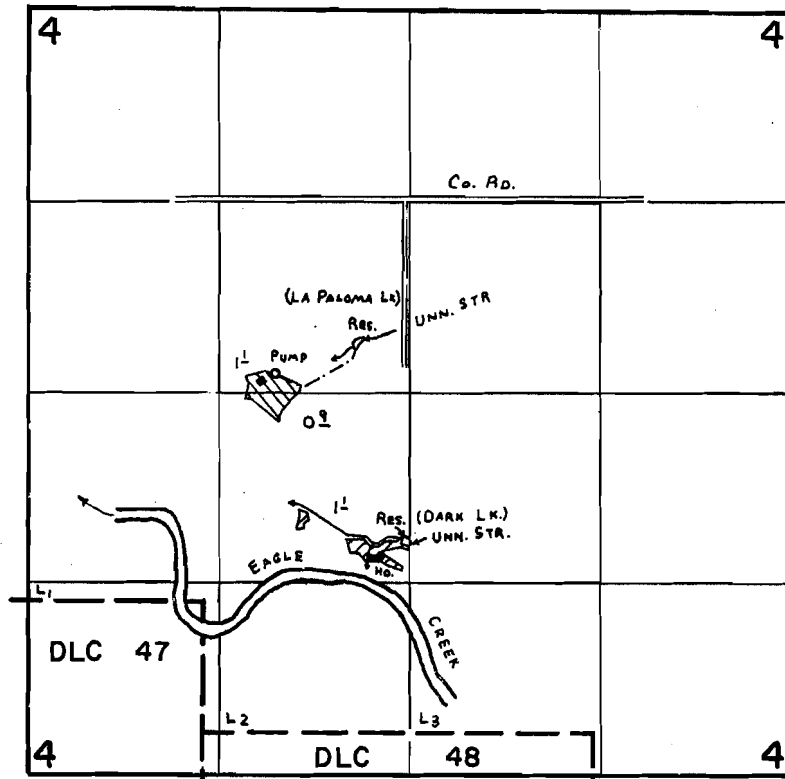

DAMS LOC: LA PALOMA LK- 2325' S. & 390' W.  
 DARK LK- 3650' S. & 50' W. } ALL FROM N 1/4 COR SEC 4.

PUMP LOC: 2510' S & 930' W.  
 [Symbol] - IRR. UNDER APP. 55808  
 [Symbol] - IRR. UNDER APP. 65810

## FINAL PROOF SURVEY UNDER

55810                      41784  
 R-55809                  R-6610  
 55808                      41783

Application No. R-55807    Permit No. R-6609  
 IN NAME OF

GEORGE W, JR. & JOSEPHINE SULLY LIND

Surveyed JULY 13, 1978, by C. L. HUGHES...