


# T3S. R4E. WM.

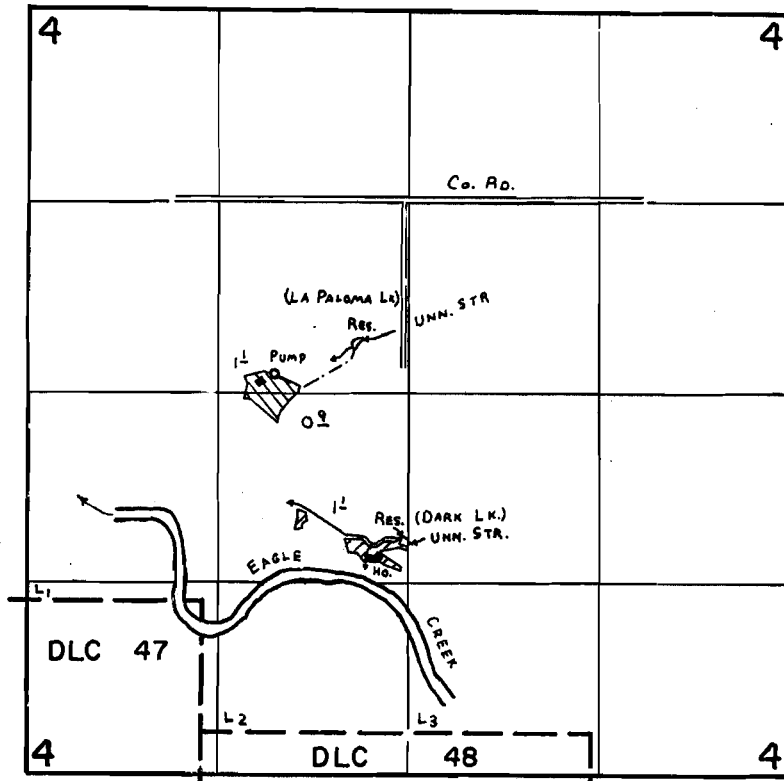

DAMS LOC: LA PALOMA LK- 2325' S. & 390' W. } ALL FROM N 1/4 COR SEC 4.  
 DARK LK- 3650' S. & 50' W.

PUMP LOC: 2510' S & 930' W.

- IRR. UNDER APP. 55808
- IRR. UNDER APP. 55810

## FINAL PROOF SURVEY UNDER

|         |        |
|---------|--------|
| 55810   | 41784  |
| R-55809 | R-6610 |
| 55808   | 41783  |

Application No. R-55807 Permit No. R-6609

IN NAME OF

GEORGE W, JR. & JOSEPHINE SULLY LIND

Surveyed JULY 13, 1978, by C. L. HUGHES