


T3S. R4E. WM.

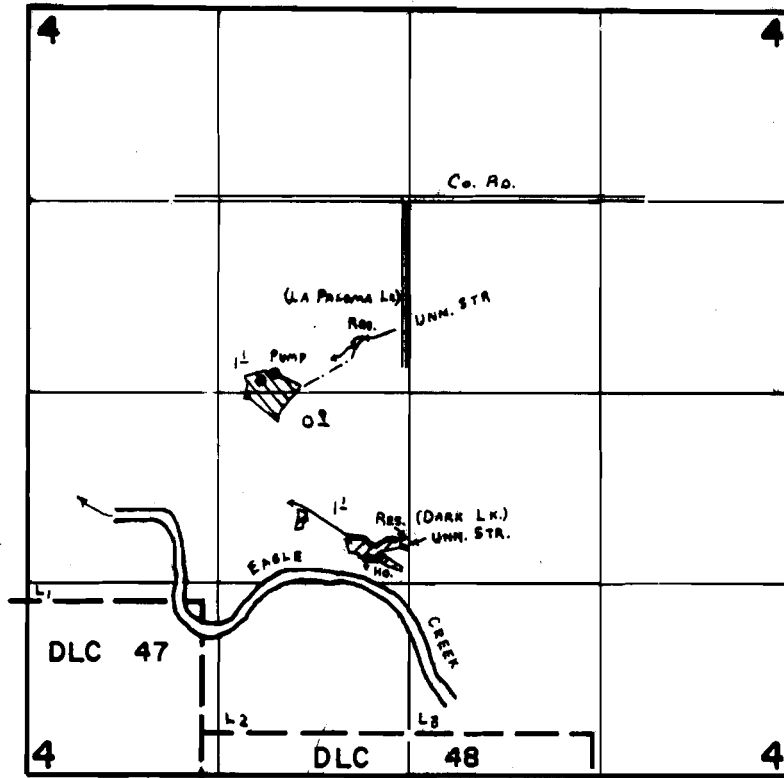

DAMS LOC: LA PALOMA LK-2325' S. & 390' W.
 DARK LK-2650' S. & 50' W. } ALL FROM N 1/4 COR SEC 4.

PUMP LOC: 2510' S & 930' W.

▨ - IRR. UNDER APP. 55808

▧ - IRR. UNDER APP. 55810

FINAL PROOF SURVEY UNDER

55810 41784
 R-55809 R-6610
 55808 41783

Application No. R-55807 Permit No. R-6609

IN NAME OF

GEORGE W. JR. & JOSEPHINE SULLY LIND

Surveyed JULY 13, 1978, by C. L. HUGHES