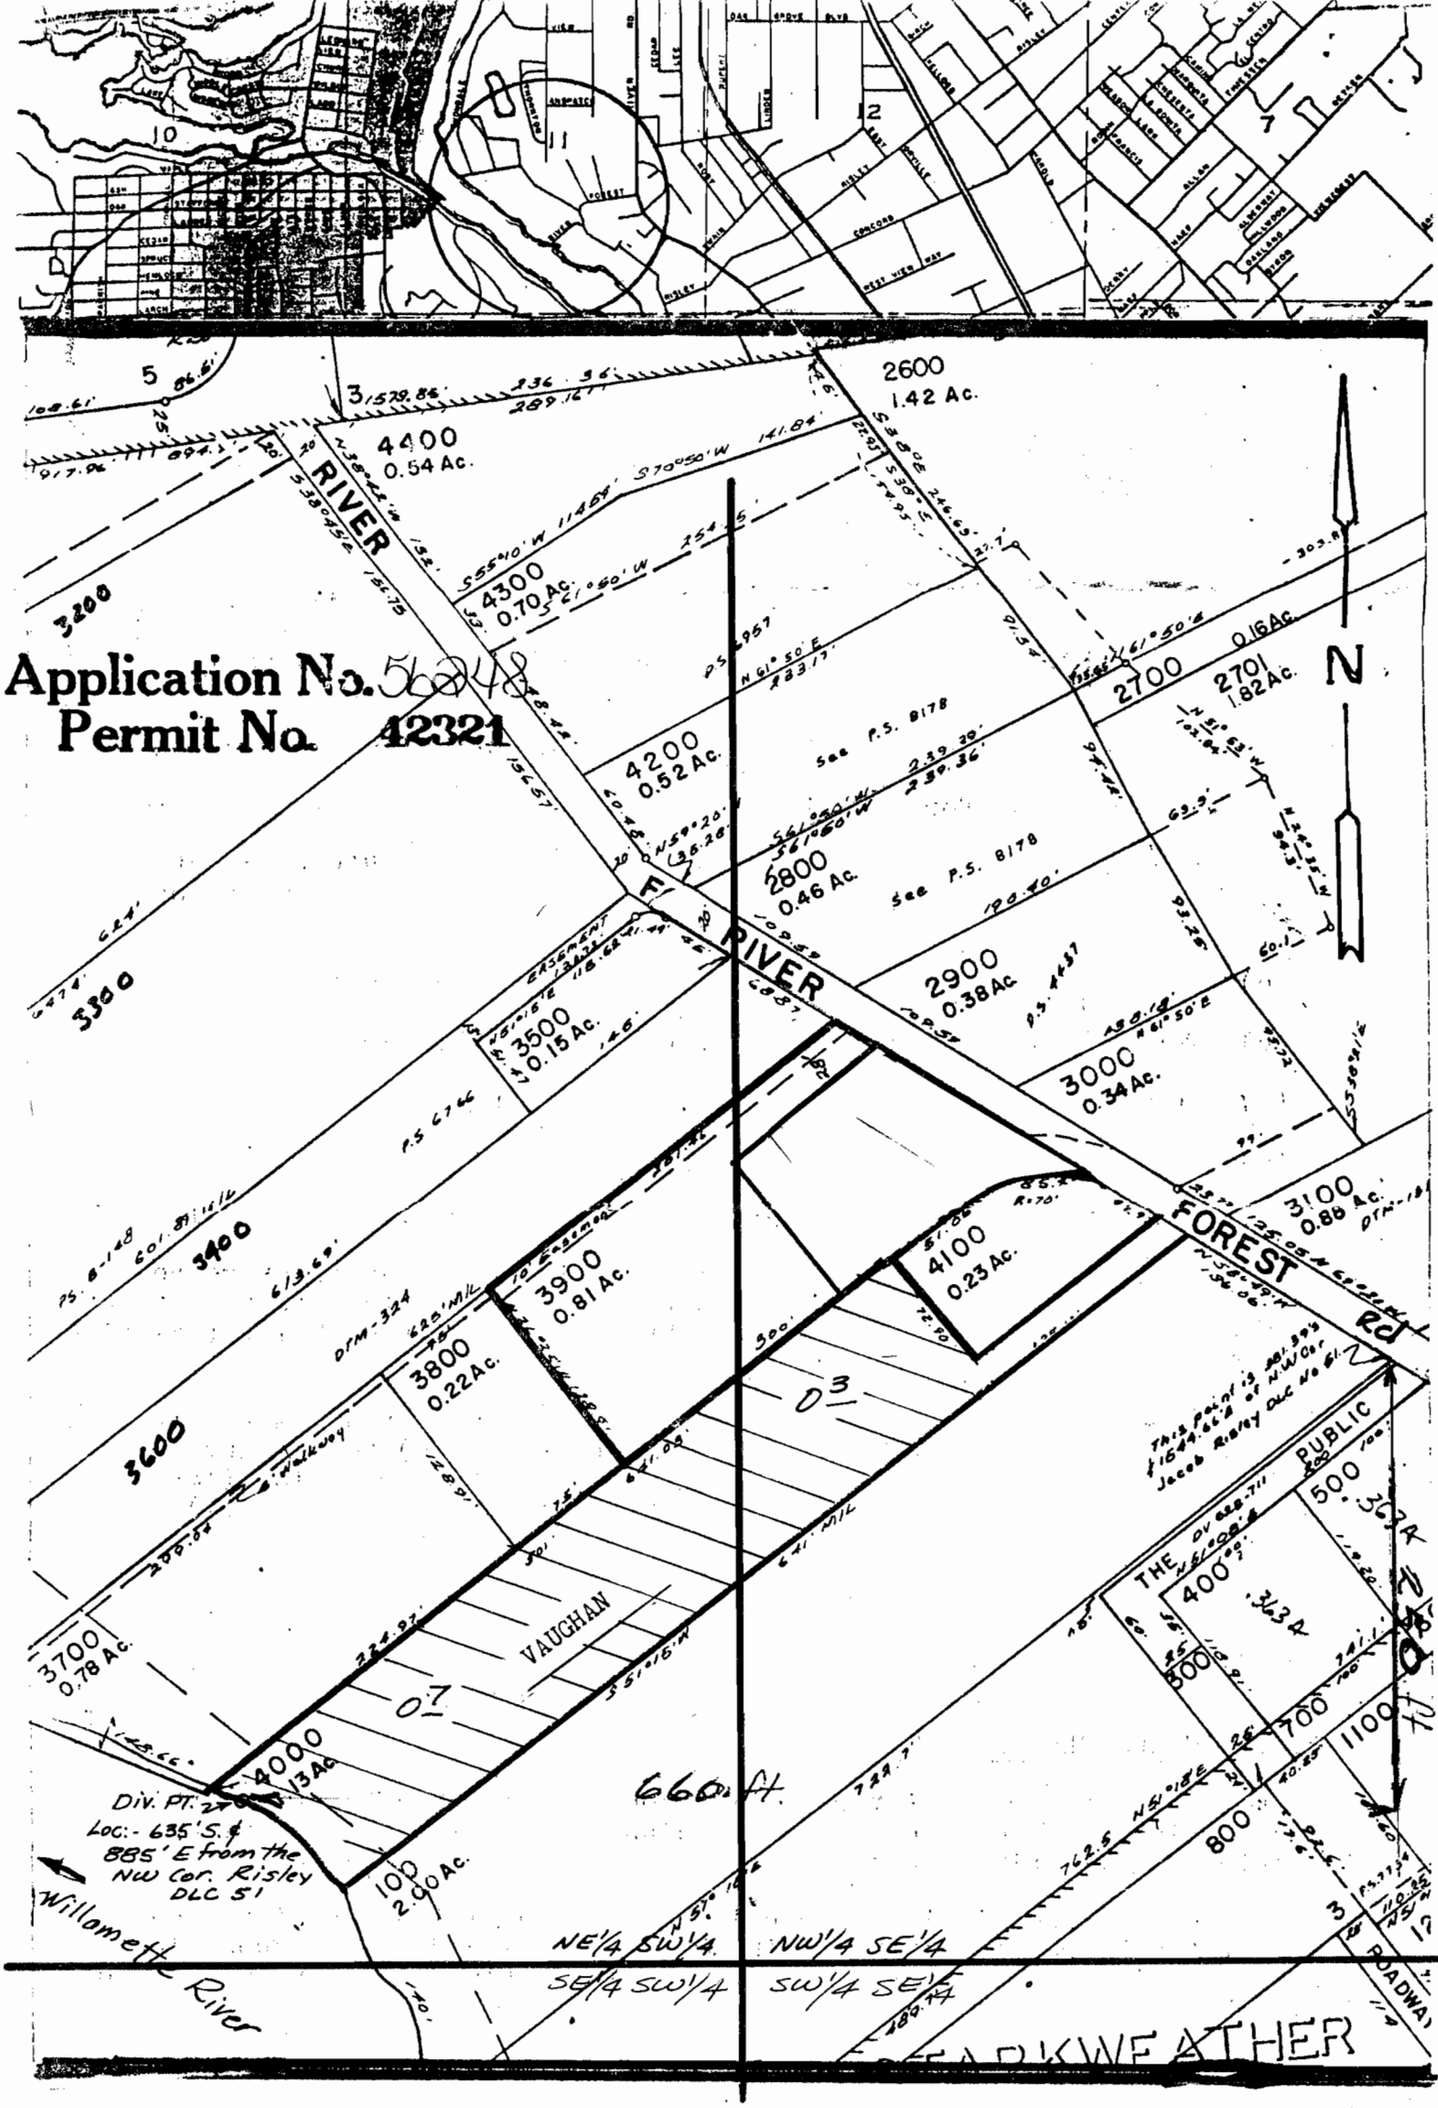

Donald F. Vaughan
June M. Vaughan

Jacob Risley DLC
Tax Lot 7
Map 1-008

SECTION 11, T2S, R1E

SCALE: 1" = 100'

RECEIVED
DEC 0 1977
WATER RESOURCES DEPT
SALEM, OREGON