


T. 4S. R. 1E. W.M.

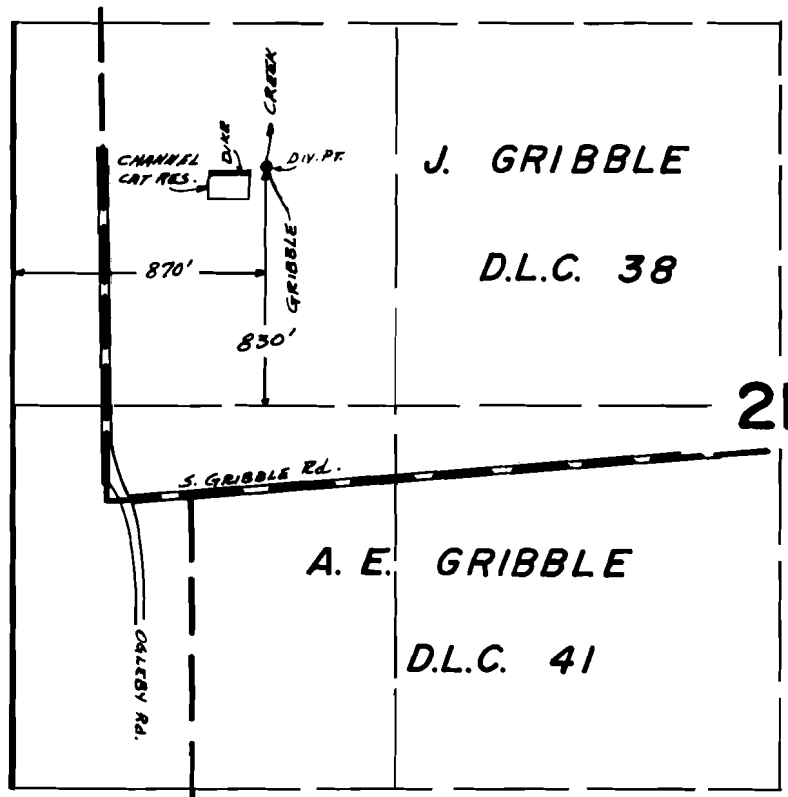

Scale - 1" = 660'

FINAL PROOF SURVEY UNDER

R-56371 R-6696
Application No. 56740 Permit No. 42311
IN NAME OF

CLARENCE J. & ANNA L. HOPMAN

Surveyed MAY 4 1978, by J.S. Donaldson