


T. 4S. R. 1E. W.M.

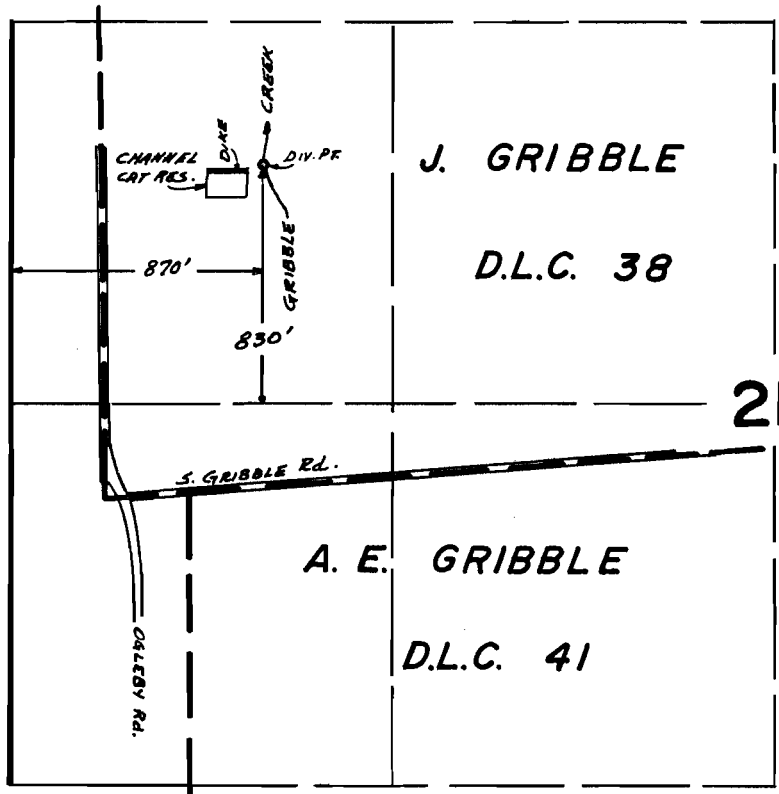

Scale - 1" = 660'

FINAL PROOF SURVEY
UNDER

Application No. R-56371 56740... Permit No. R-6696 42311...
IN NAME OF

CLARENCE J. & ANNA L. HOPMAN

Surveyed MAY 4 1978, by J.S. Donaldson