


T6S. R2E. WM.

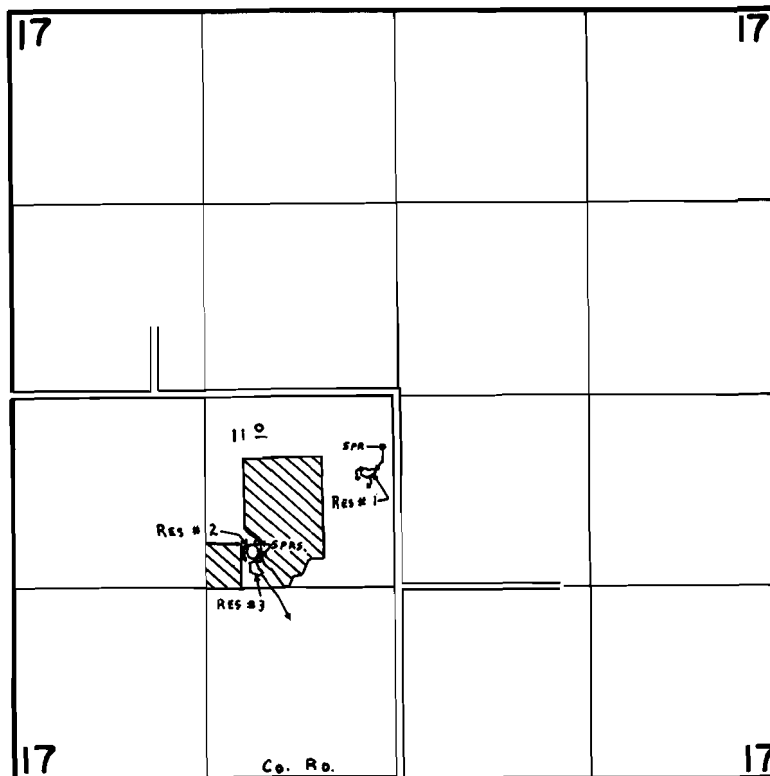

RES. LOC: #1 - 550'S. & 220'W.
 #2 - 1100'S. & 1010'W.
 #3 - 1220'S. & 980'W.
 SPRS. LOC: #1 - 350'S. & 100'W.
 #2 - 1000'S. & 840'W.
 #3 - 1120'S. & 950'W.

ALL FROM C. 1/4 COR. SEC. 17.

FINAL PROOF SURVEY UNDER

Application No. 56567 Permit No. 42407
 R-56566 R-6712
 IN NAME OF

ROMAN J. & LENORE WOLF

Surveyed AUG. 2 1978, by C. L. HUGHES