


T6S. R2E. WM.

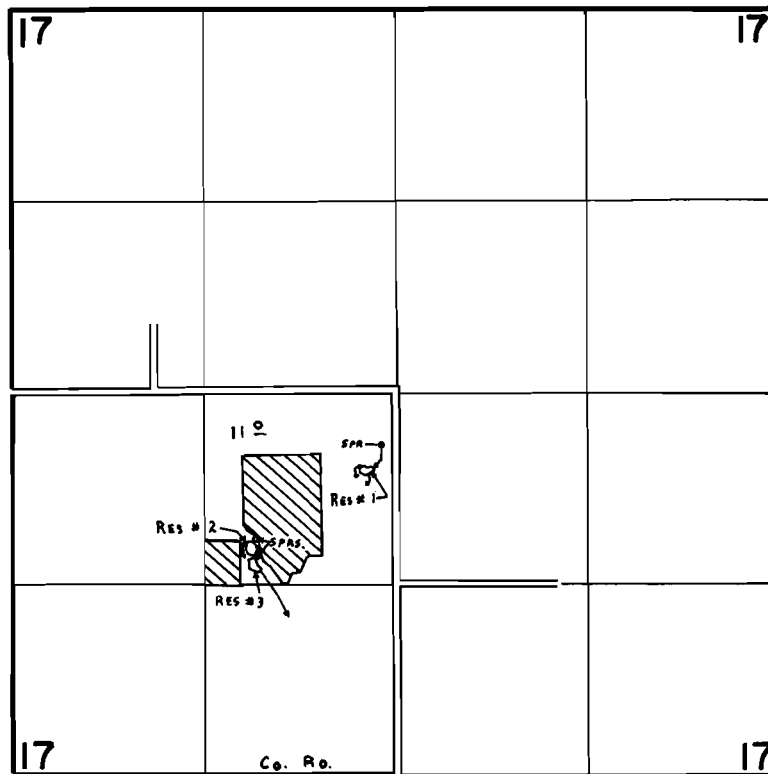

RES. LOC: #1 - 550'S. 220'W.
#2 - 1100'S. 1010'W.
#3 - 1220'S. 980'W.
SPRS. LOC: #1 - 350'S. 100'W.
#2 - 1000'S. 960'W.
#3 - 1120'S. 950'W. } ALL FROM C. 1/4 COR. SEC. 17.

FINAL PROOF SURVEY
UNDER

Application No. 56567 Permit No. 42407
R-56566 R-6712
IN NAME OF

ROMAN J. & LENORE WOLF

Surveyed AUG. 2, 1978, by C. L. HUGHES