


T2S. RIE. WM.

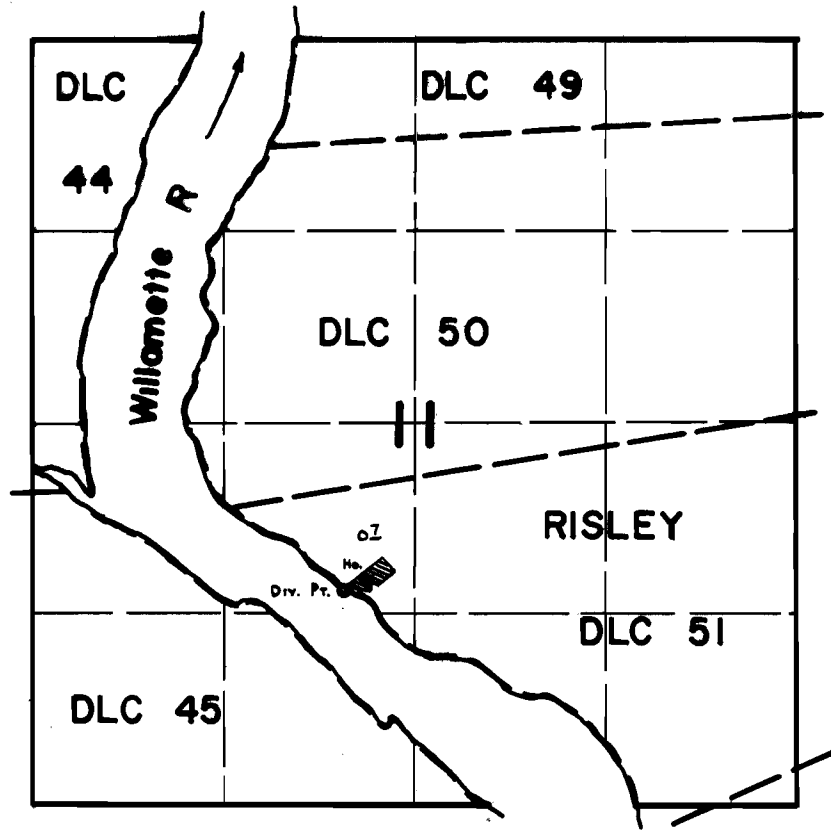

Div. Pt. Loc: 575' S. & 780' E. fr. N.W. Cor. RISLEY D.L.C. 51.

FINAL PROOF SURVEY UNDER

Application No. 57074 Permit No. 42921
IN NAME OF

CHESTER T. & LORRAINE L. SCOTT

Surveyed OCT. 16 1978, by C. L. HUGHES