


SECTION 36 T. 4S. R. 2E. W.M.
CLACKAMAS COUNTY

1" = 400'

100
9.10 Ac.

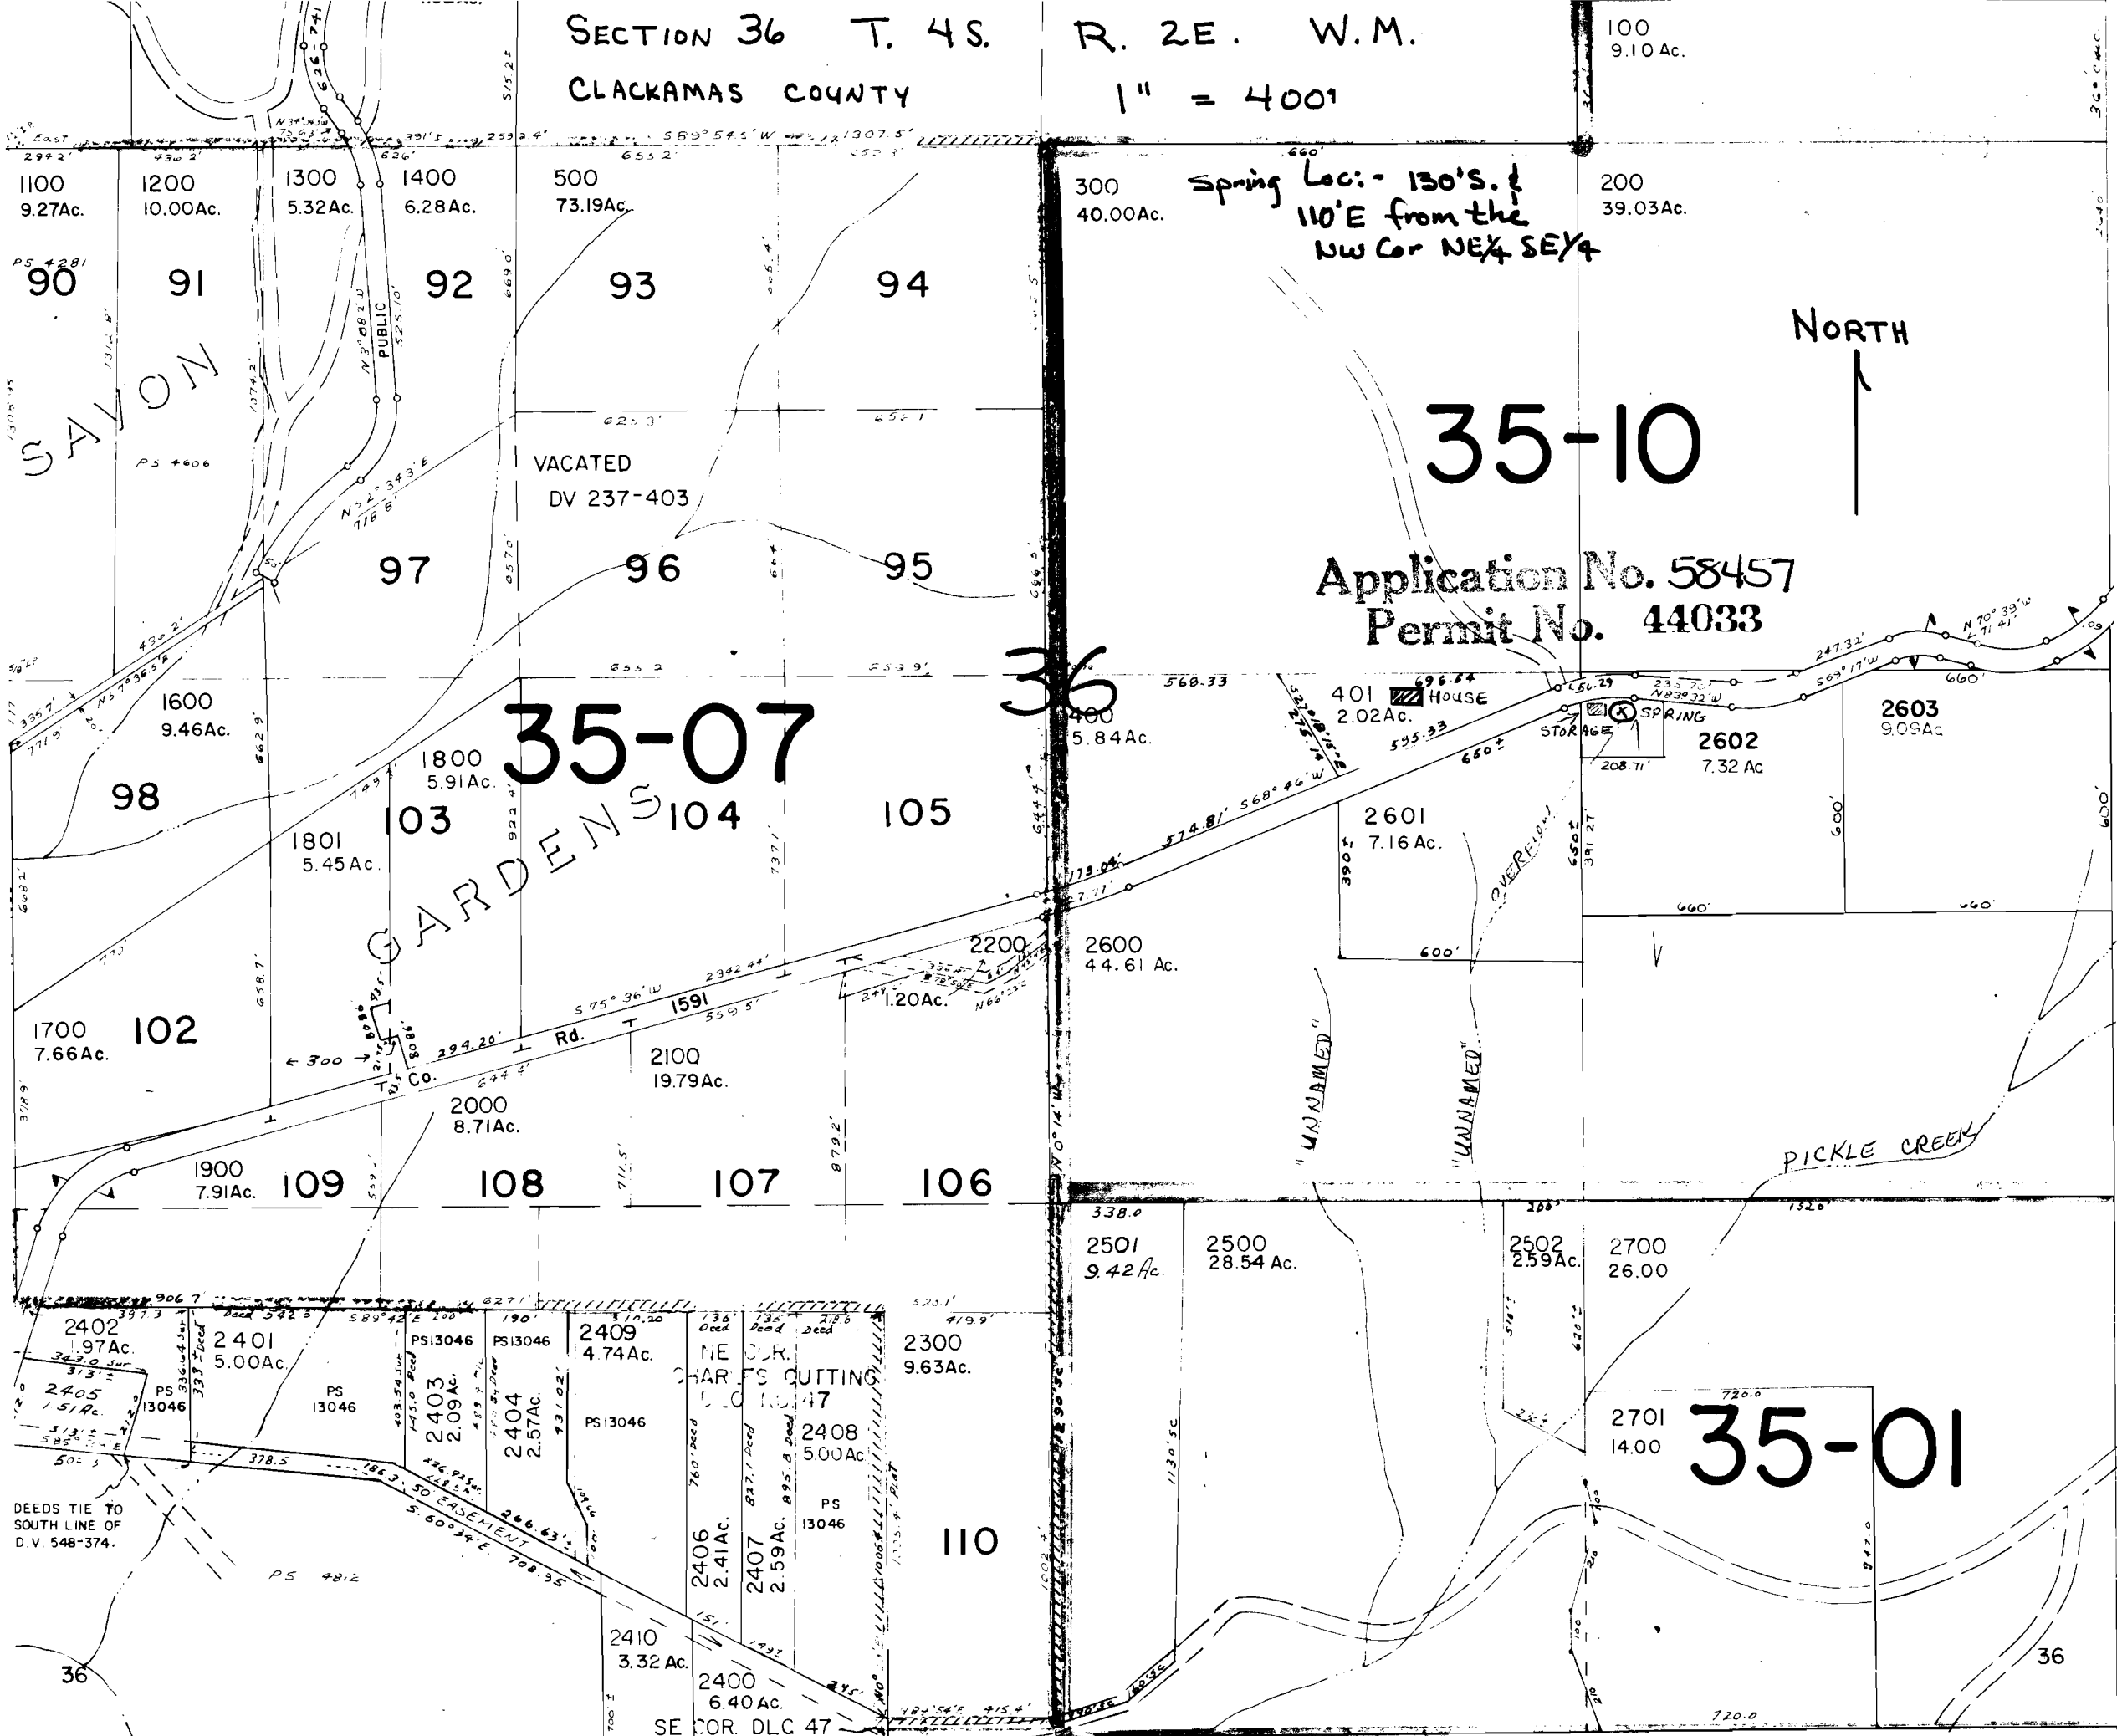

Spring Loc: - 130'S. &
110'E from the
NW Cor NE 1/4 SE 1/4

NORTH

35-10

Application No. 58457
Permit No. 44033

35-07

35-01

DEEDS TIE TO
SOUTH LINE OF
D.V. 548-374.

36

36