


T6N. R6W. WM.

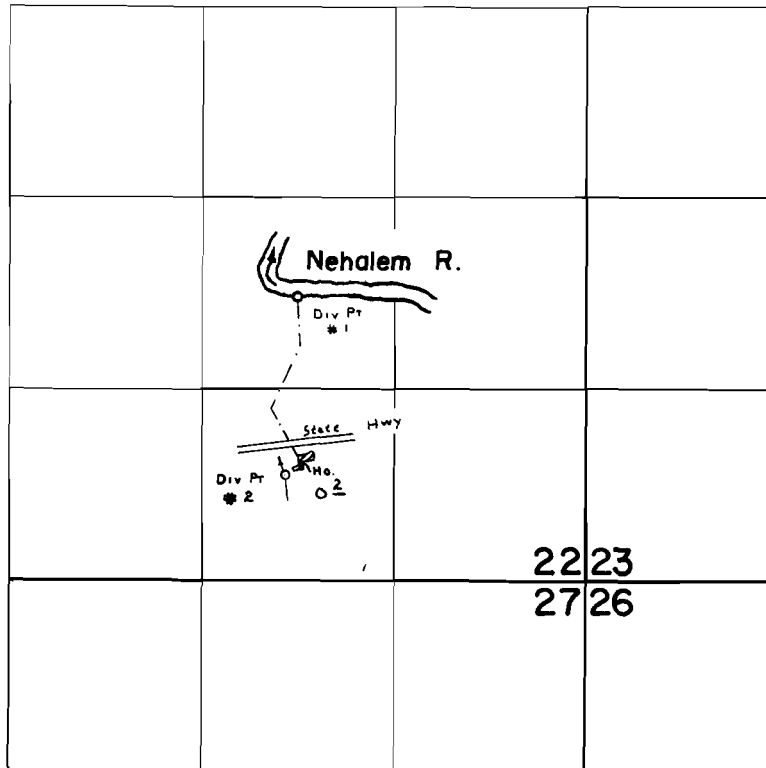

Div Pt #1 (A-57398) Loc: 1950' N & 1980' W } both fr. SE Cor Sec 22.
Div Pt #2 (A-56929) Loc: 720' N & 2070' W }

FINAL PROOF SURVEY
UNDER

Application No. 56929 57398 Permit No. 42756 43235
IN NAME OF

JOHN H. OBER

Surveyed SEPT 20 1978, by C L HUGHES