


T.28S. R.13W. W.M.

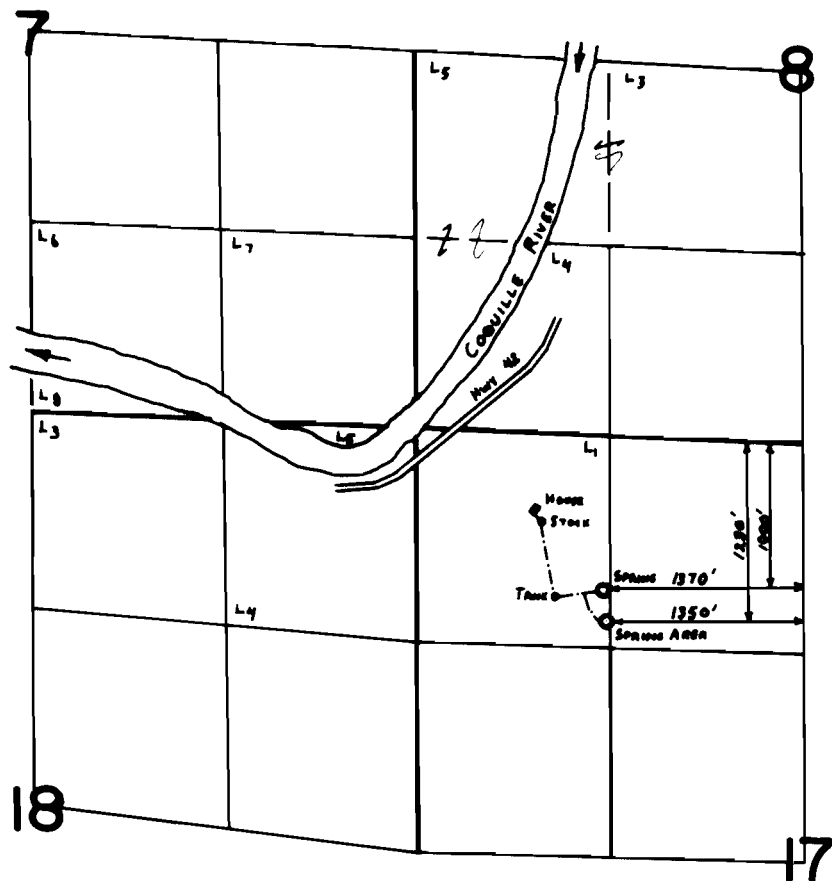

**FINAL PROOF SURVEY**  
UNDER

Application No. 54425... Permit No. 40812...  
IN NAME OF

**CEDRIC CROSS**

Surveyed April 19... 1978, by B.R. SUND.....