


T.25S. R.6W. W.M.

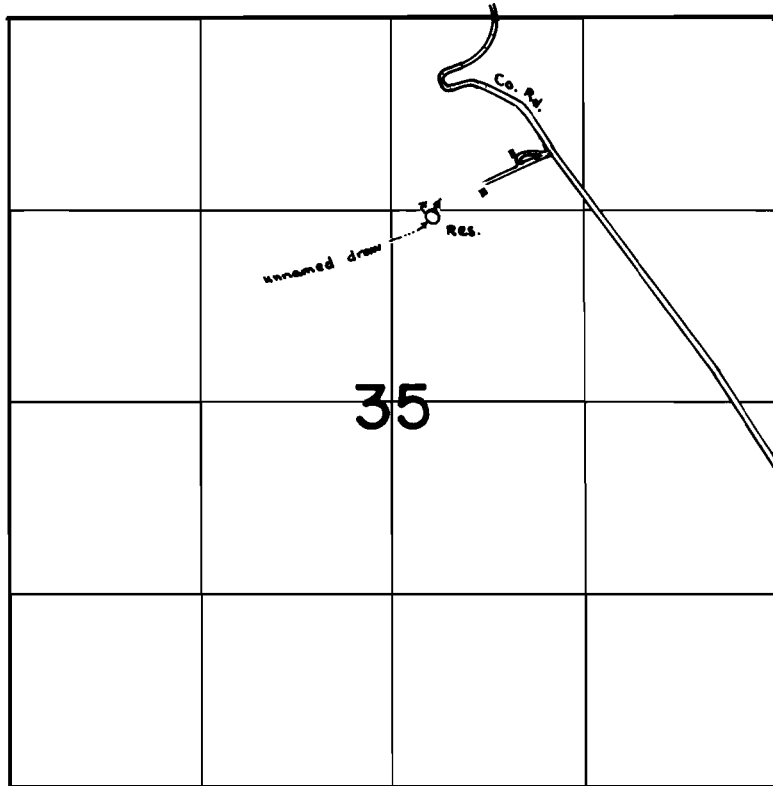

SCALE: 4" = 1 mile

FINAL PROOF SURVEY
UNDER

Application No. R-48868 Permit No. R-5930
IN NAME OF

Richard L. & Faye A. Fink

Surveyed July 17, 1979, by S. Donaldson