


T.29S. R.4W. W.M.

Sec. 8

NE 1/4 SW 1/4

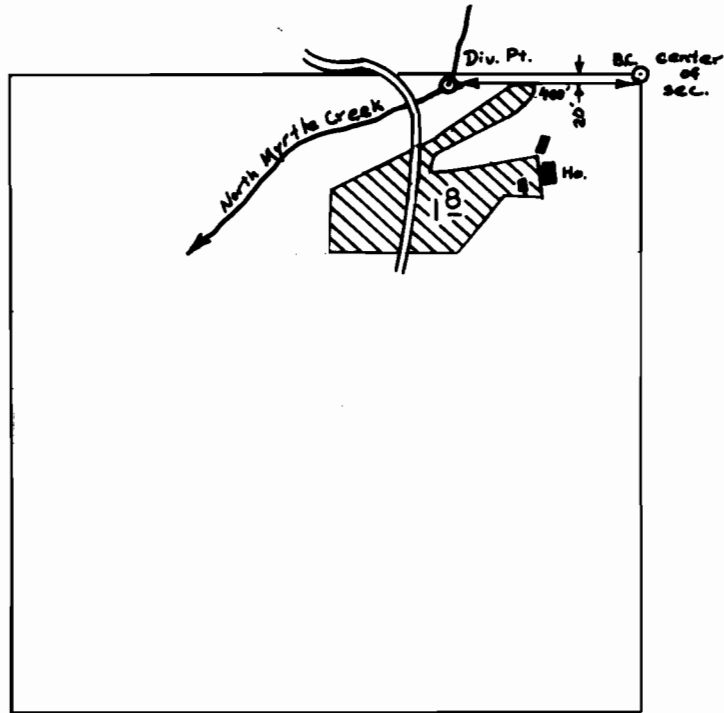

SCALE : 1" = 400'

**FINAL PROOF SURVEY**  
UNDER

Application No. 50671 Permit No. 38280  
IN NAME OF

Robert W. & Hazel M. Redding

Surveyed March 13 1979, by S. Donaldson