


T.22 S.R.8 & 9 W.W.M.

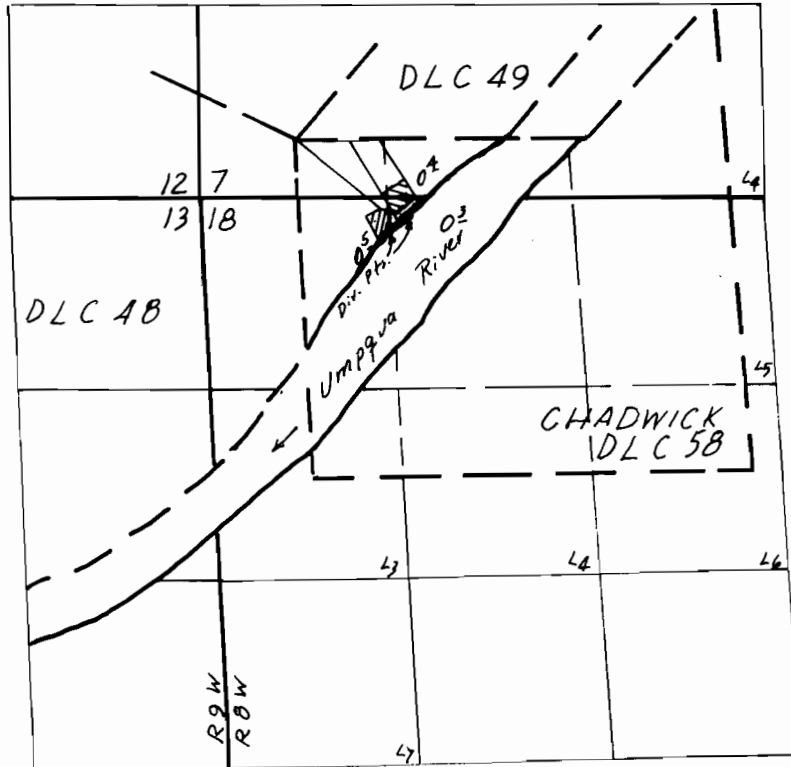

Diversion Points: 240' S & 1320' E; 140' S & 1450' E both
NW corner Sec. 18 T22S RBW WM

FINAL PROOF SURVEY UNDER

Application No. 54743 41066 Permit No. 52599 29663

IN NAME OF

Paul T. & Lola M Tempel

Jaka R. & Betty L. Buas

Inspection Surveyed Sept. 5, 1981, by J.S. Donaldson