


T. 29 S., R. 7 W., W.M.

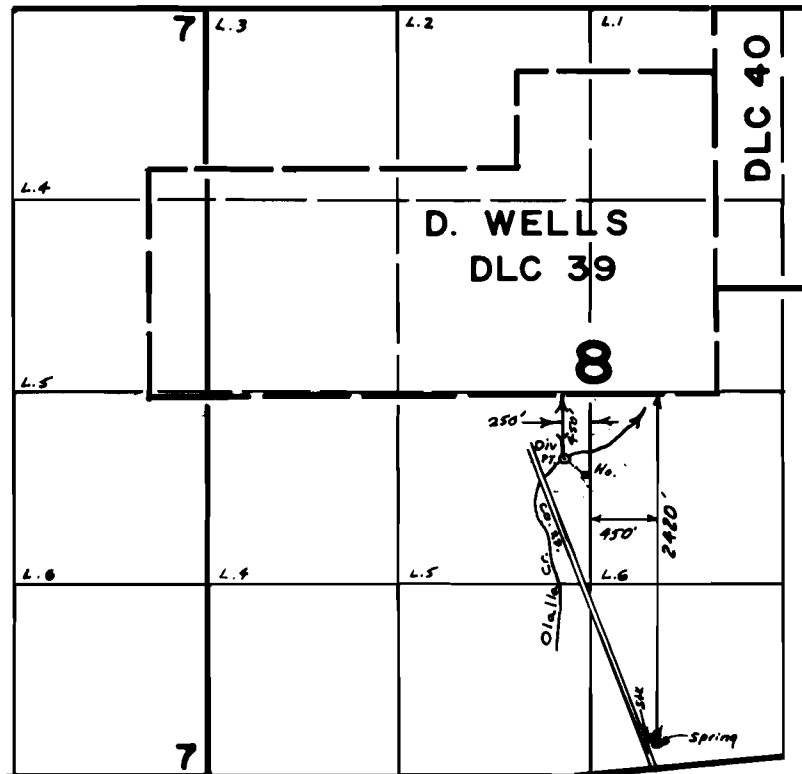

SCALE 4"=1mile

FINAL PROOF SURVEY UNDER

Application No. 53351... Permit No. 39582..
IN NAME OF

Bernadine S. Chand

Surveyed JUNE 5, 1979, by S. Donaldson..