


T.24S., R.6W., W.M.

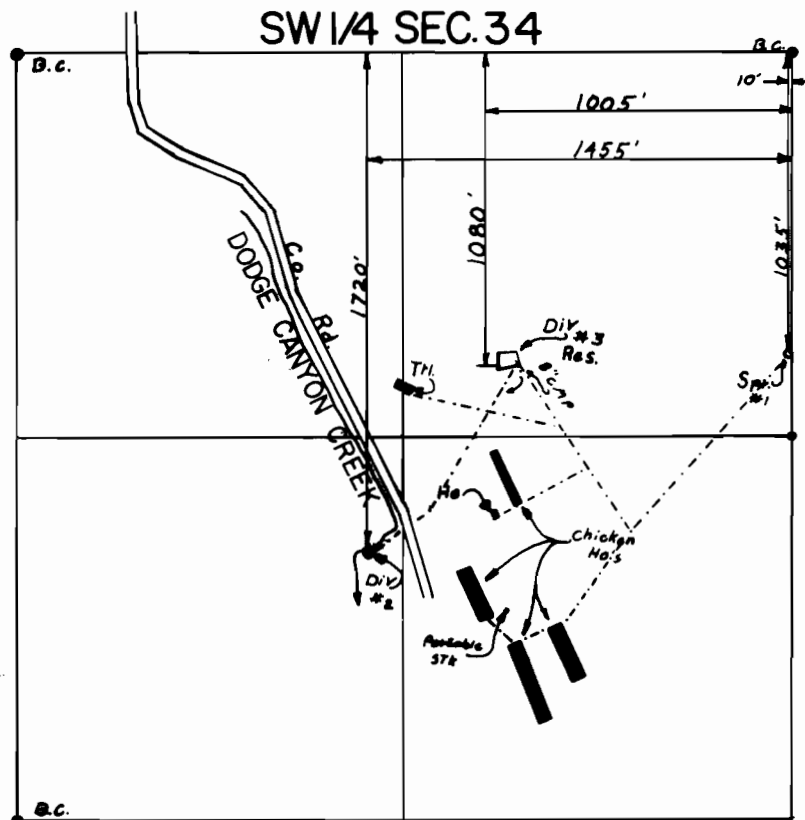

SCALE: 1" = 660'

FINAL PROOF SURVEY
UNDER

R-53699 R-6410
Application No. 53700 Permit No. 40147
IN NAME OF

ALVIN & ETHEL JOHNSON

Surveyed NOV. 3, 1977, by D.W. SPARKS