


40447

50303

d

T. 14S. R. 31E. W.M.

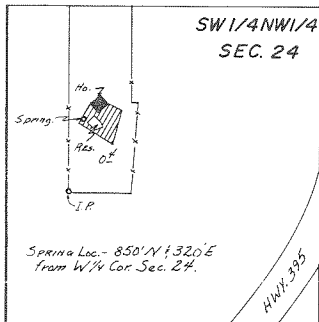

Scale 1" = 400'

FINAL PROOF SURVEY
UNDER

R-53063

R-6458

Application No. 53064 Permit No. 40447
IN NAME OF

JOHN HAFER

Surveyed Aug. 28 1978, by J.S. Donaldson.