


T24S. R34E. WM.

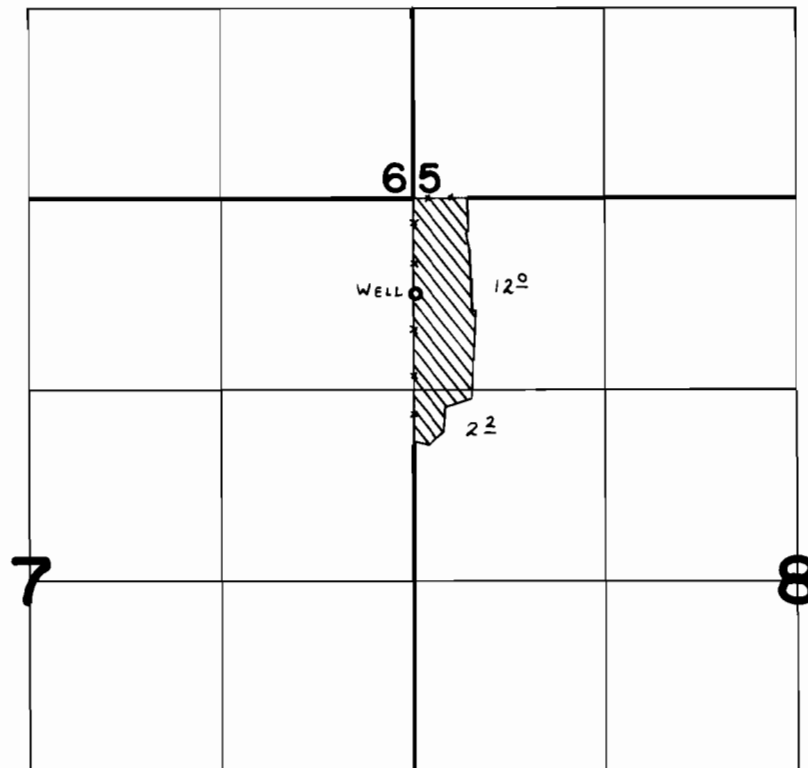

WELL LOC: 670' S. fr. N.W. COR. SEC. 8.

FINAL PROOF SURVEY
UNDER

Application No. G-7725 Permit No. G-7172
IN NAME OF

GENE KRUEGER

Surveyed AUG. 29 1978, by C. L. HUGHES.