


# T24S. R30E. WM.

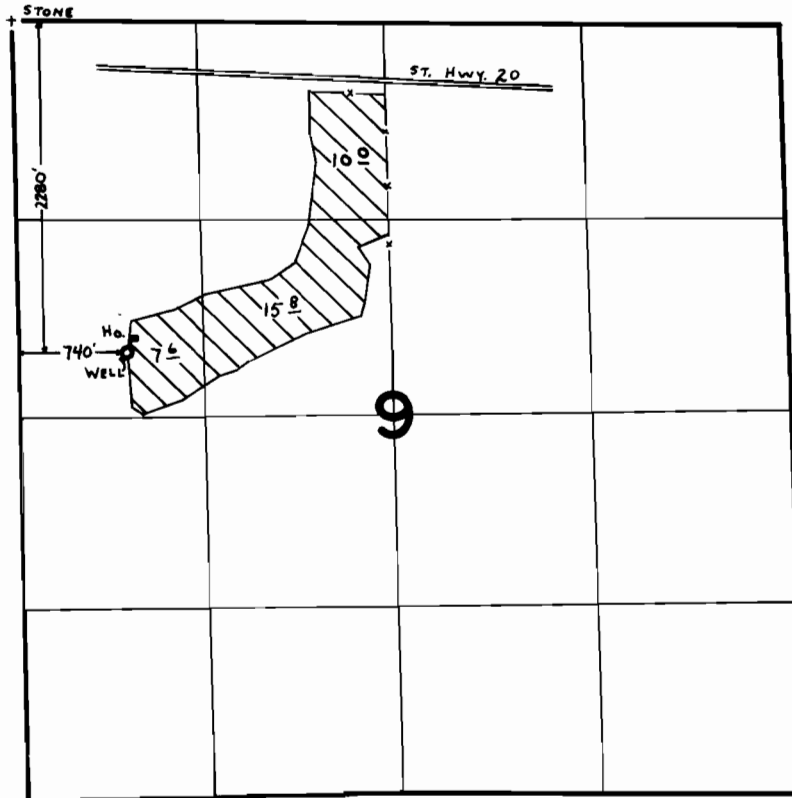

## FINAL PROOF SURVEY UNDER

Application No. G-7988 Permit No. G-7411  
IN NAME OF

HAROLD WOODRUFF

Surveyed AUG. 24 1978, by C. L. HUGHES.