


Will. Met. T. 21S., R. 32 1/2 E., Sec. 25, SE 1/4 SE 1/4
 POINT OF DIVERSION - 500 ft. N + 750 ft. W from
 SE corner of Sec. 25

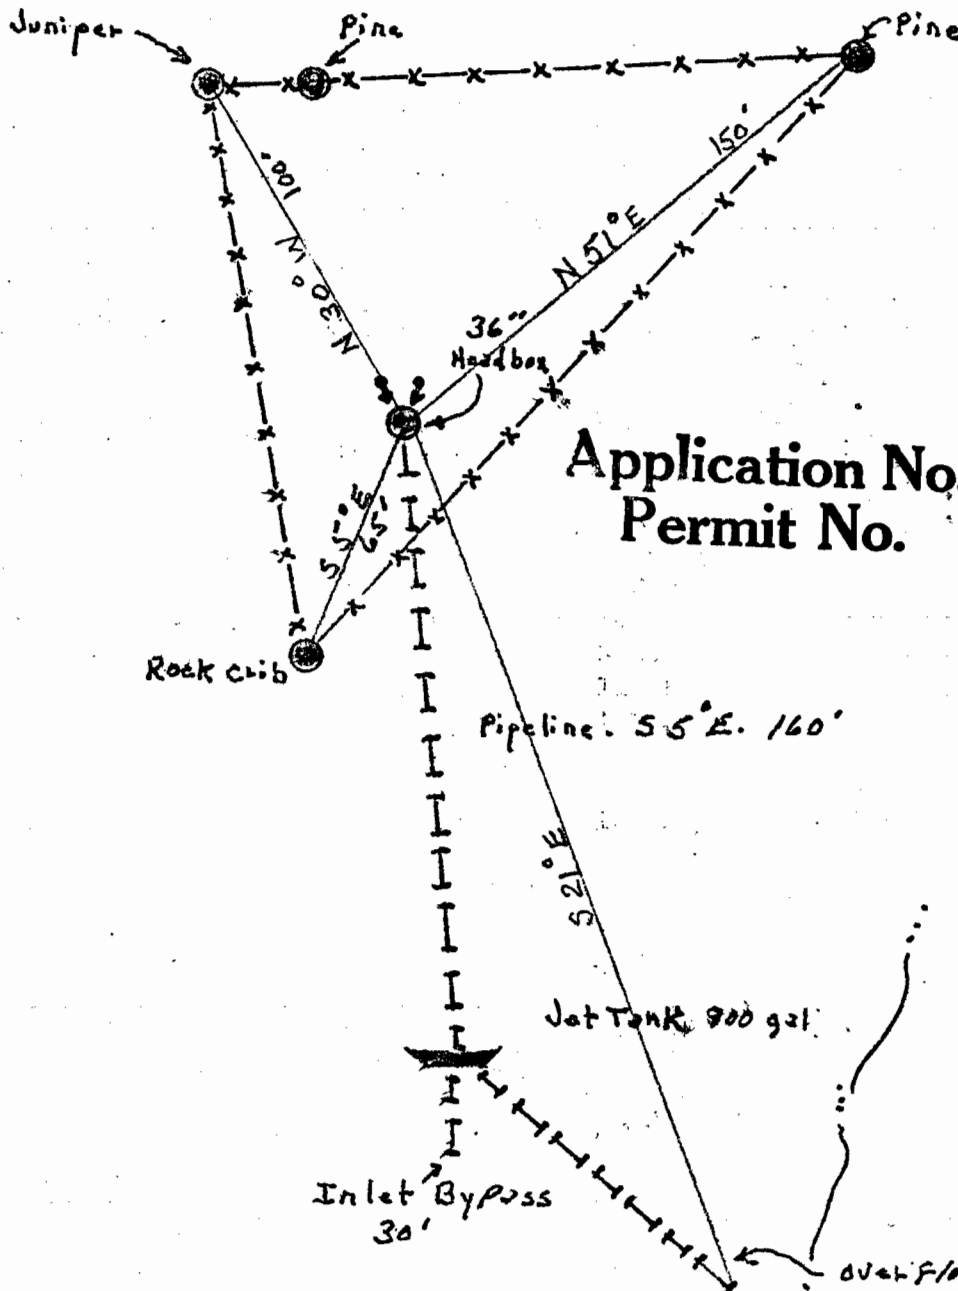

Scale: 1" = 50'

Application No. 56721
 Permit No. 42878

Rate of Flow = 1.5
 gpm

Orangeberg Pipe - Springs to Headbox - 2, 8' Sections (Two Sources)

Plastic Pipe - 2" 100 PSI

By-pass & Overflow ends - Casing

Fence - 5 1/2' steel spaced 11' w/ 2 stays