


T. 38 S., R. 3 W., W.M.

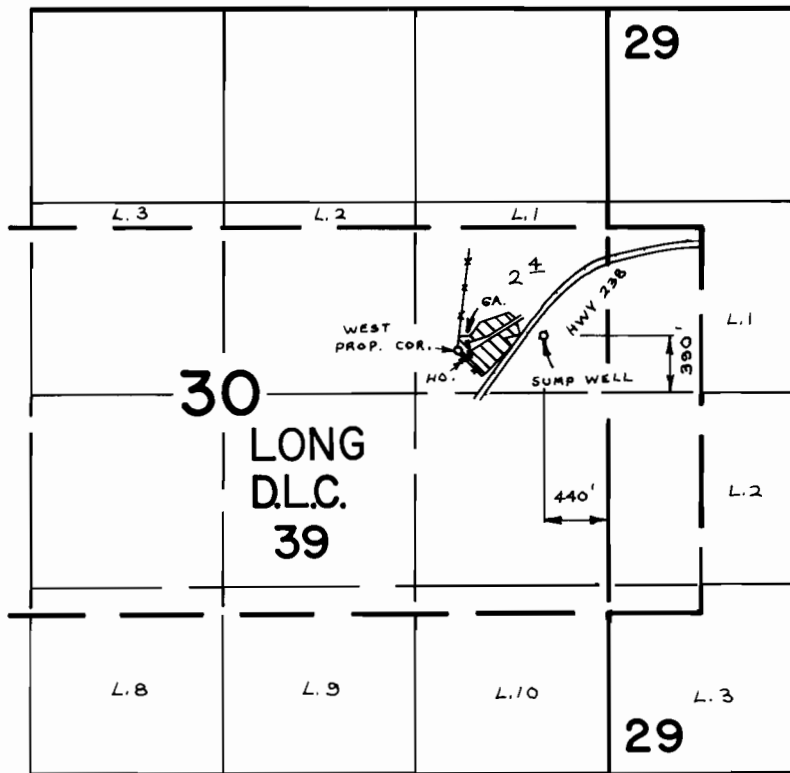

FINAL PROOF SURVEY
UNDER

Application No. G-8034 Permit No. G-7448
IN NAME OF

WESLEY &/OR BETTE OFFENBACHER

Surveyed OCT. 13 78 by B. SUND
19.....

D.H.M.
P.T.S. - 1978 - 14 - D