


T.38S., R.28&3 W., W.M.

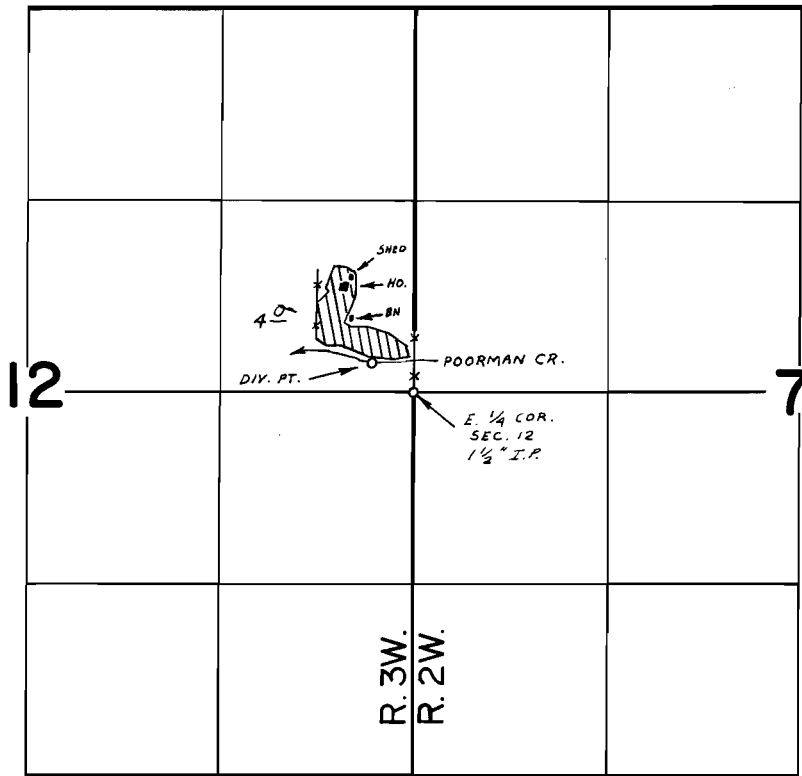

DIV. PT. LOC.: 200' N. & 280' W. FROM E. 1/4 COR. SEC. 12

FINAL PROOF SURVEY
UNDER

Application No. 54173 Permit No. 40556

IN NAME OF

DANIEL VIENNA

Surveyed JUN. 13 1978 by B. SUND