


# T. 36 S., R. 3 W., W.M.

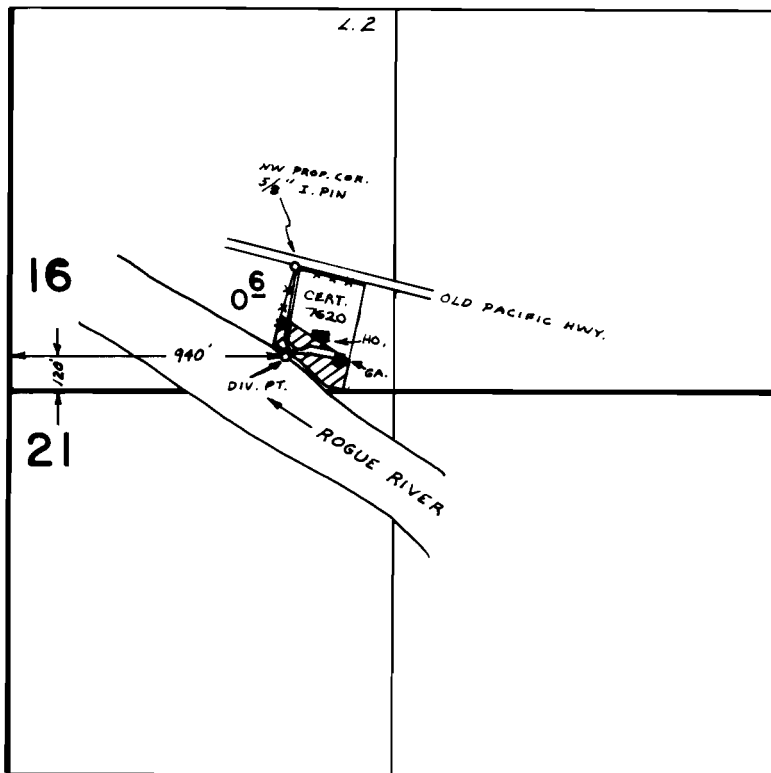

SCALE: 1" = 660 FT.

## FINAL PROOF SURVEY UNDER

Application No. 54395 Permit No. 40764  
IN NAME OF

FRANCIS C. &/OR BERNADINE E. MC CONNELL

Surveyed NOV. 14 78 by B. SUND  
19.....