


T. 35 S., R. 1 W., W. M.

SEC. 17

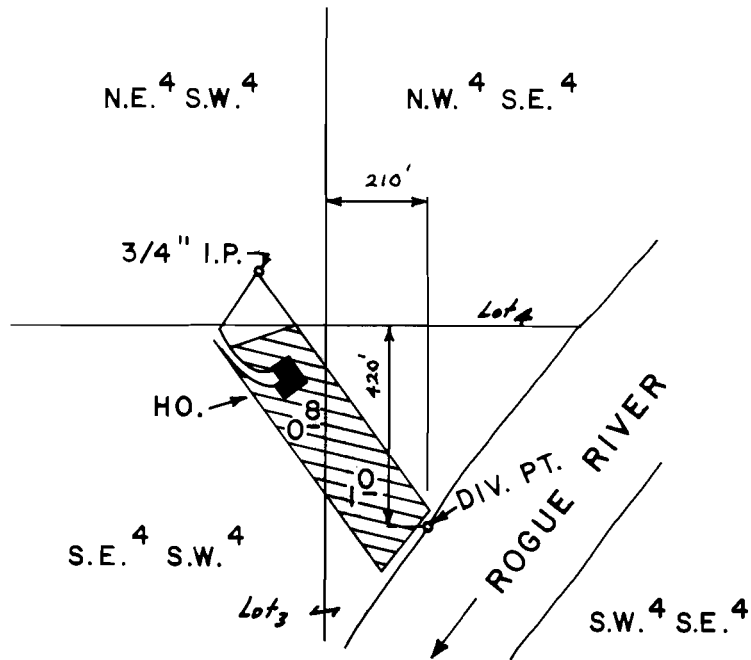

SCALE : 1" = 400 FT.

FINAL PROOF SURVEY UNDER

Application No. 56278 Permit No. 42140
IN NAME OF

MRS. JOANNA GIVAN

Surveyed MAY 15 1979, by B. SUND

D.H.M.

P.T.S. - 1979 - 14 - A

BAX - 3AA - 59