


T37S., R.8W., W.M.

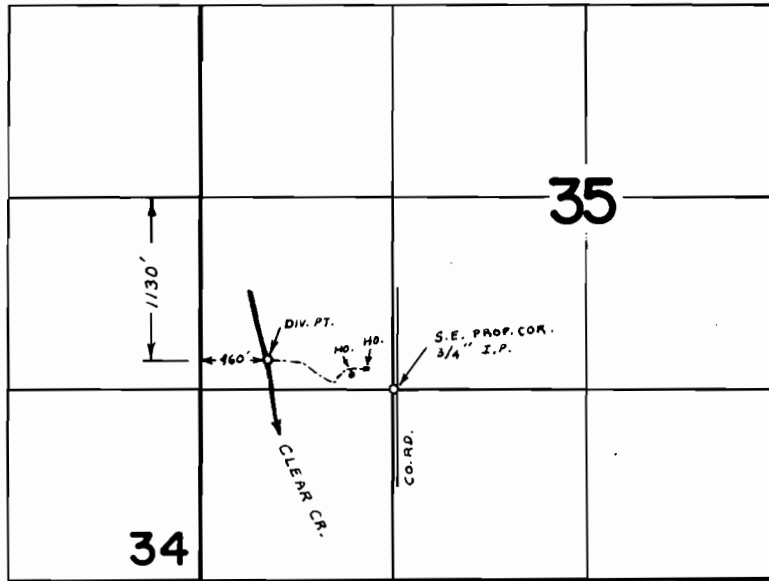

**FINAL PROOF SURVEY  
UNDER**

Application No. 48892 Permit No. 36049  
IN NAME OF

DOUGLAS MICHAEL FREIER

Surveyed OCT. 27 78 by B. SUND  
19.....