


G 5738  
50822

# T. 39S., R. 19E., W.M.

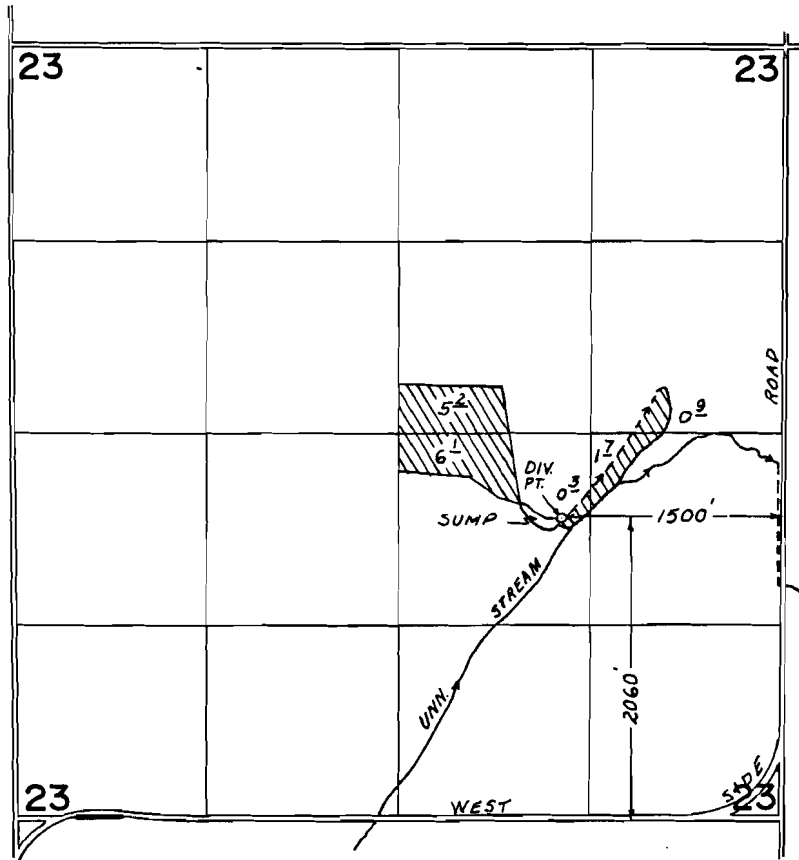

## FINAL PROOF SURVEY UNDER

Application No. G-6022 Permit No. G-5738  
IN NAME OF

*Myron L. & Judith A. Steward*

Surveyed JUNE 7, 1980, by C.L. HUGHES

CHZ-GKK-80 BB