


G6653  
56823

# T40S. R19E. WM.

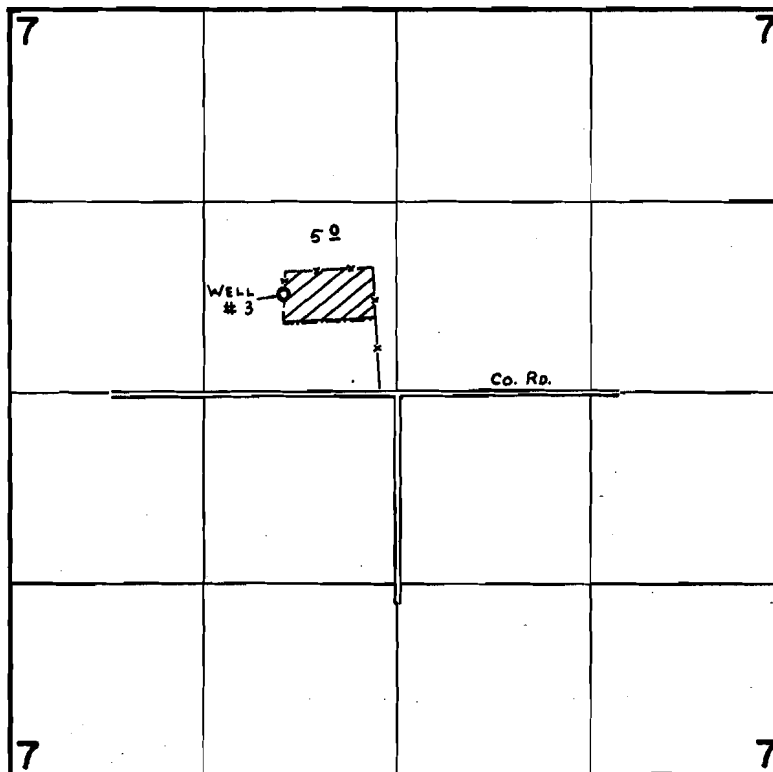

WELL Loc.: 680' N. & 680' W. fr. C.  $\frac{1}{4}$  COR SEC. 7.

## FINAL PROOF SURVEY UNDER

Application No. G-7251 Permit No. G-6653  
IN NAME OF

R. F. RICHARDSON

Surveyed JUNE 26 1978, by C. L. HUGHES