


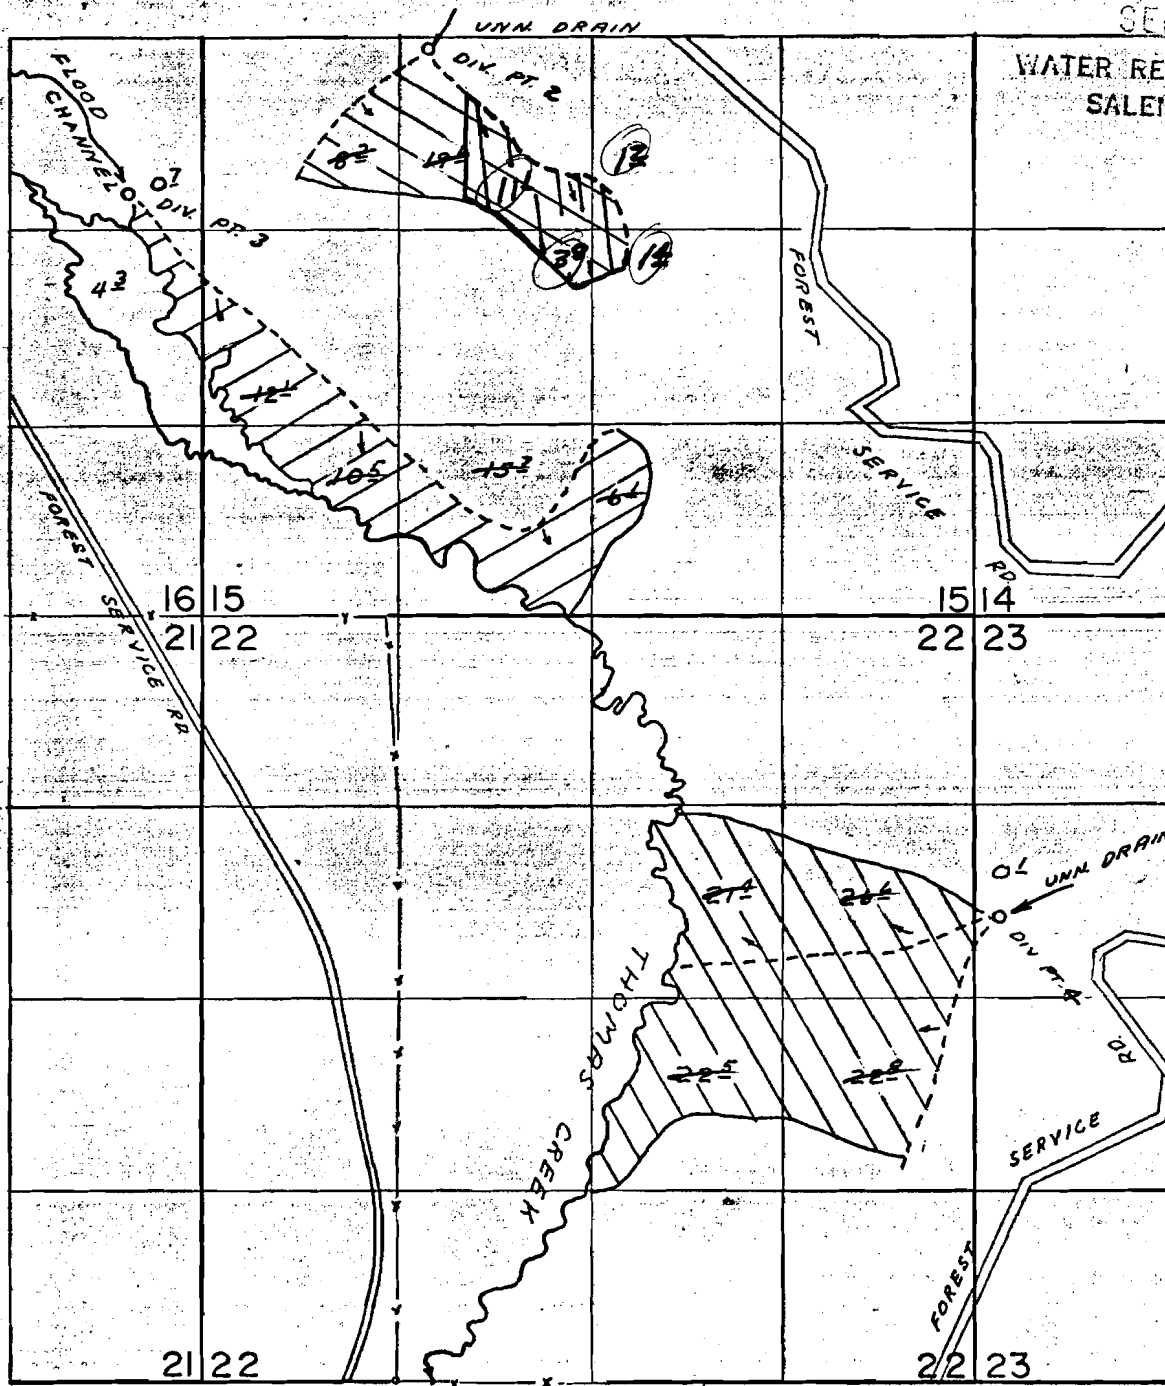


T.37S. R.18E. W.M.

50825
RECEIVED

SEP 26 1977

WATER RESOURCES DEPT
SALEM, OREGON



-  DIV. PT. 1
UNNAMED
DRAIN
-  DIV. PT. 2
FLOOD
CHANNEL
THOMAS CR.
-  DIV. PT. 3
UNNAMED
DRAIN

DIV. PT. LOC., 2- 9150' N. & 180' E., 3- 8140' N. & 1840' W., 4- 3220' N. & 4110' E.
ALL FROM SW COR. SE 1/4, SW 1/4, SEC. 22

FINAL PROOF SURVEY UNDER

~~APPLICATION NO. 44488 PERMIT NO. 33272~~

Application No. **56658**
Permit No. **42039**

IN NAME OF

LEAVITT LIVESTOCK CO.

~~SURVEYED JUL 15, 1975, BY L.H. NUNN~~

CH 50825