


T.15S. R.4 W., W.M.

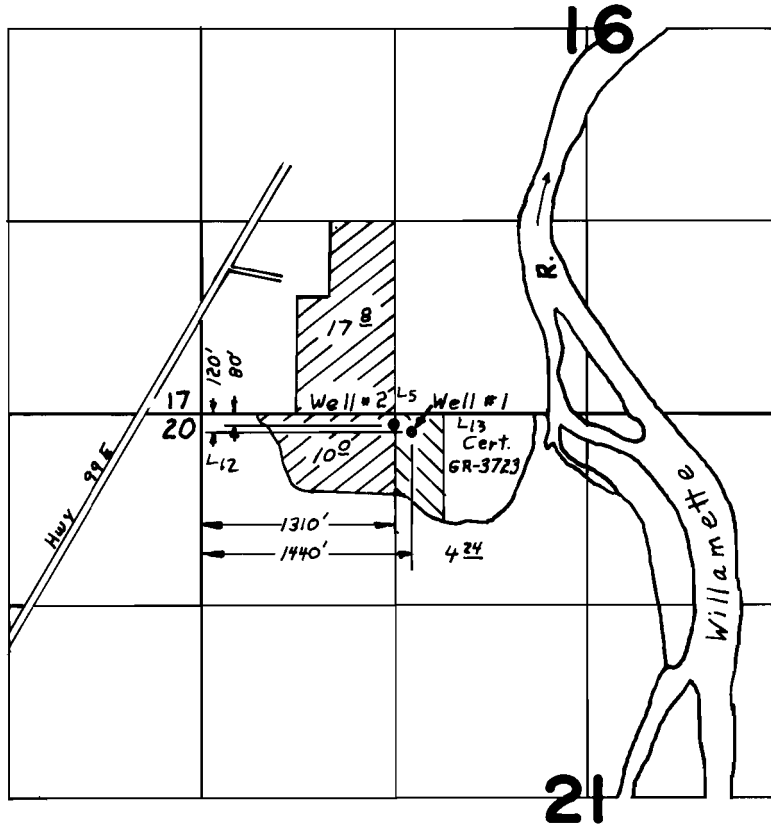

-  Well #1
-  Well #2

FINAL PROOF SURVEY UNDER

Application No. G-5458 Permit No. G-7781...
IN NAME OF

.....VIOLA STRETCH.....

Surveyed APR...24 1978, by J.S. DONALDSON