T.15S. R.4W., W.M.

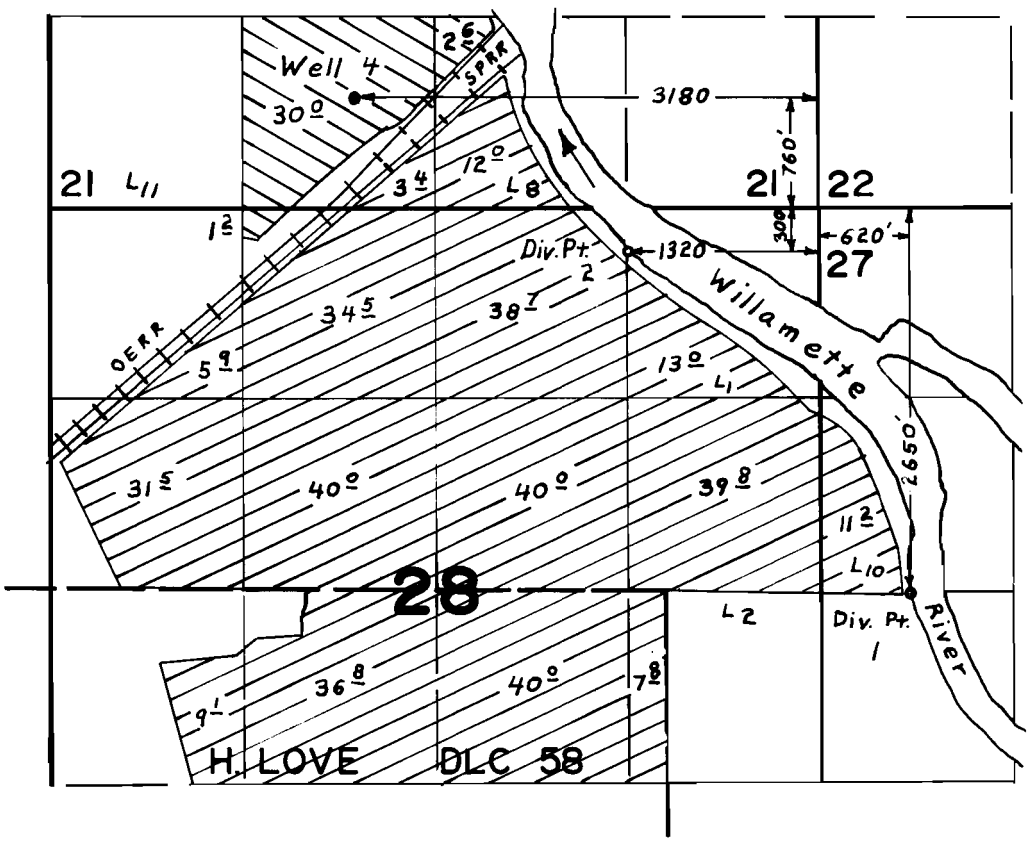

App'l. G-5751

App'l. 44044

FINAL PROOF SURVEY
UNDER

Application No. G-5751 (49049) Permit No. G-5537 (36701)

IN NAME OF

RODNEY B and AILEEN R KRAGNESS

Surveyed APR. 25 1978, by J. S. DONALDSON

OFM-133-30